

Map No. _____ Sec. 26 Twp. 15 R. 13WWell No. 6 Sellens

Sunray _____ Company

FIRST REPORT

Contractor

SE NE

SECTION PLAT

_____ Ft. from N. Line

330 Ft. from S. Line330 Ft. from E. Line

_____ Ft. from W. Line

Russell County

Location X

Rig up _____

Drilling and Remarks:

RECORD

Cased _____ in., _____ ft.

Sand _____

Gas _____

Oil _____

Total Depth _____

PRODUCTION

1st 24 hrs. Nat. _____

1st 24 hrs. after shot _____

Gas _____ Cu. Ft.

Dry Hole _____

Abandoned _____

Date

APR 7 1948 19 S. J. LEWIS ScoutMap No. 73 Sec. 26 Twp. 15 R. 13WWell No. 6 Hafferman

Sunray _____ Company

CORRECTION

Contractor

SE NE

SECTION PLAT

_____ Ft. from N. Line

330 Ft. from S. Line330 Ft. from E. Line

_____ Ft. from W. Line

Russell County

Location _____

Rig up _____

Drilling and Remarks:

Reported as

#6 Sellens

RECORD

Cased _____ in., _____ ft.

Sand _____

Gas _____

Oil _____

Total Depth _____

PRODUCTION

1st 24 hrs. Nat. _____

1st 24 hrs. after shot _____

Gas _____ Cu. Ft.

Dry Hole _____

Abandoned _____

Date

APR 14 1948 19 S. J. LEWIS Scout

KANSAS

Russell ✓

Sec. 26 Twp. 15 R. 13W

Well No. #6 Sallens Hafferman Farm

Sunray

Company


Trapp

Ft. from N. Line

330 Ft. from S. Line

330 Ft. from E. Line

Ft. from W. Line

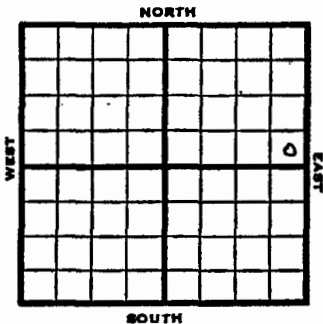

SE NE

1948

8/11

TD 3336' 1000 acid
17 bbls oil PH 6 hrs.

8/18

Arb. 3326'

7" @ 3327'

TD 3336'

1000 acid

Pump 100' oil Pot

409 Gr.

Comp

COMPLETED

1948	Eli 1879& REPORT
4/7	Location
4/14	"
4/21	"
4/28	"
5/5	10" @ 546' WOC
5/12	Lansing 3003' Arbuckle 3326' TD 3329' 7" @ 3327' RUST
5/19	TD 3336' 1000 Acid 17 bbls oil PH, 6 hrs.
5/26	"
6/1	"
6/9	"
6/16	"
6/23	"
6/29	"
7/ 8	"
7/14	"
7/21	"
7/28	"
8/4	"

OVER

SAS Russell

Russell County Kansas State

Map No. 73 Sec. 26 Twp. 15 R. 13WWell No. 6 Hafferman


Sunray

Company

COMPLETE

Contractor

SE NE

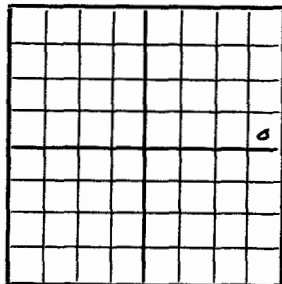E11879
SECTION PLAT

Ft. from N. Line

330 Ft. from S. Line330 Ft. from E. Line

Ft. from W. Line

Trapp Pool

Remarks:

*Cell 3326**7 "C 3327**YD 3336**10000 cu ft**Pump 100 oil P & X**40 3/4*

Date

AUG 1 1948


Scout

S. J. LEWIS

Section 26 Township 15 Range 13WWell No. #6 Sellen HaffermanCompany Sunray

Trapp Pool

NORTH

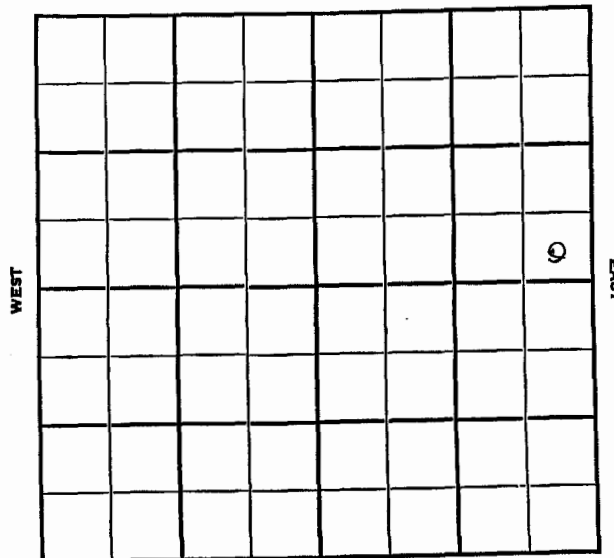

SOUTH