

Trapp Pool

Map No. _____ Sec. 26 Twp. 15 R. 13W

Well No. 1 Taylor

Berwick-Spurill & Harms Company

FIRST REPORT

Contractor

NW SE SE

SECTION PLAT

_____ Ft. from N. Line

990 _____ Ft. from S. Line

990 _____ Ft. from E. Line

_____ Ft. from W. Line

Russell County

Location _____

Rig up _____

Drilling and Remarks:

8" @ 220 WOC

RECORD

Cased _____ in., _____ ft.

Sand _____

Gas _____

Oil _____

Total Depth _____

PRODUCTION

1st 24 hrs. Nat. _____

1st 24 hrs. after shot _____

Gas _____ Cu. Ft.

Dry Hole _____

Abandoned _____

Date

APR 7 1948 19 S. J. LEWIS Scout

Trapp Pool

Map No. 73 Sec. 26 Twp. 15 R. 13W

Well No. 1 Taylor

Berwick-Spurill & Harms Company

COMPLETE

Contractor

NW SE SE

SECTION PLAT

_____ Ft. from N. Line

990 _____ Ft. from S. Line

990 _____ Ft. from E. Line

_____ Ft. from W. Line

Russell County

Location _____

Rig up _____

Drilling and Remarks:

Per 7846

4 1/2 "C3349 1/2

Pump 20 oil Per

402

RECORD

Cased _____ in., _____ ft.

Sand _____

Gas _____

Oil _____

Total Depth 3251

PRODUCTION

1st 24 hrs. Nat. _____

1st 24 hrs. after shot _____

Gas _____ Cu. Ft.

Dry Hole _____

Abandoned _____

Date

JUL 8 1948 19 S. J. LEWIS Scout

KANSAS

Russell

Sec. 26 Twp. 15 R. 13W

Well No. #1 Taylor Farm

Berwick-Spurill & Harms Company


Trapp

Ft. from N. Line

990 Ft. from S. Line

990 Ft. from E. Line

Ft. from W. Line

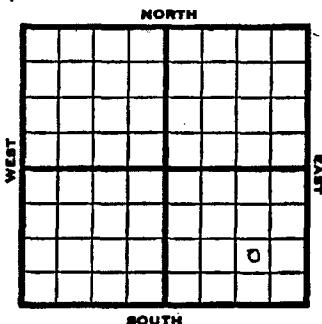

NW SE SE

1948 Elev. 1878' REPORT

4/7 8" @ 220'
WOC

4/14 Drlg. 2950'

4/21 TD 3344'
4 1/2" @ 3348 1/2'
RUST

4/28 Lansing 3058'
Arbuckle 3346'
TD 3351'
Swb. 1 bbls. oil PH 8 hrs.

5/5 "

5/12 "

5/19 "

5/26 "

6/1 "

6/9 "

6/16 "

6/23 "

6/29 "

OVER

1948

7/8 Arbuckle 3346'
4 1/2" @ 3349 1/2'
Pump 20 oil Pot.
Gr. 40.90
TD 3351'

COMPLETED

Section 26 Township 15 Range 13WWell No. #1 TaylorCompany Berwick-Spurill & Harms

Trapp Pool

NORTH

