

County Russell State Kansas
 Sec. 26 (Blk. 15) (Sur. 13W) Map No.
 Operator Jones, Shelburne, Inc.
 Well No. 3 Farm Sellens "B"
 Elev. 1830 Location SE NW NW
 990 Ft. From N Line NW
 990 Ft. From W Line Quarter
 1st. Report SEP 23 1953
 Completion
 Remarks
Julian Cable tools
 Spudding Date

Drig. Data Trapp Pool
RUCT

J. G. McGEHEE


County Russell State Kansas
 Sec. 26 (Blk. 15) (Sur. 13W) Map No.
 Operator Jones, Shelburne, Inc.
 Well No. 3 Farm Sellens "B"
 Elev. 1830 Location SE NW NW
 990 Ft. From N Line NW
 990 Ft. From W Line Quarter
 1st. Report
 Completion DEC 9 1953
 Remarks Trapp Pool
Julian Cable tools
 Spudding Date 9-29-53

Drig. Data Oil well TD 3297
15" @ 435 13" @ 780 Anhy 776
10" @ 2065 Tarkio 2370 8" @ 2485
Lans. 3003 Arb. 3293 TD 3297
5" @ 3297 CO to 3297 500 A S/ 12 boph
Comp. 25 bopd

J. G. McGEHEE

Russell KANSAS
 SEC. 26 TWP. 15 R. 13 W
 WELL NO. # 3 Sellens "B"
 COMPANY FARM
 Jones, Shelburne, Inc.
 CONTRACTOR

Trapp Pool
 990 Ft. from N. Line
 Ft. from S. Line
 Ft. from E. Line
 990 Ft. from W. Line
 SE NW NW

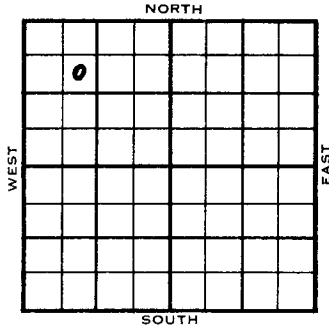

1953	ELEVATION	REPORT
	1830'	Julian C/T
9/23	RUCT	
9/30	Drlg 240'	
10/7	15" @ 135 13" @ 780	
	Anhy 776' Drlg. 800'	
10/14	Drlg. 1595'	
10/21	10" @ 2065	
	Drlg. 2080'	
10/28	Drlg. 2485'	
11/4	Tarkio 2370'-80' 8" @ 2485'	
	Lans 3003'	
11/11	Drlg. 3272'	
11/18	Arb. 3293' TD 3297' 5" @ 3297	
12/9	Spud 9-29-53 Oil well TD 3297'	
	15" @ 435 13" @ 780 Anhy 776	
	10" @ 2065 Tarkio 2370 8" @ 2485	
	Lans. 3003' Arb. 3293 TD 3297	
	5" @ 3297 CO to 3297 500 A	
	S/12 BOPH	
	Comp. 25 BOPD	
	COMPLETED	

DX-78

Russell KANSAS
 FORM 51
 Section 26 Township 15 Range 13W
 Well No. #3 Sellens "B"
 Company Jones, Shelburne Inc.

