

County Russell State Kansas
 Sec. 26 (Blk. 15) (Sur. 13W) Map No.
 Operator Jones, Shelburne & Farmer
 Well No. 2 Farm Sellens "B"
 Elev. _____ Location SW NW NW

990 Ft. From N Line NW330 Ft. From W Line Quarter1st. Report APR 1 1953

Completion _____

Remarks _____

J-S-F - Contr.Spudding Date 3-30-53

Drig. Data _____

Trapp Pool

J. G. McGEHEE

County Russell State Kansas
 Sec. 26 (Blk. 15) (Sur. 13W) Map No.
 Operator Jones, Shelburne & Farmer
 Well No. 2 Farm Sellens "B"
 Elev. 1834 Location SW NW NW

990 Ft. From N Line NW330 Ft. From W Line Quarter

1st. Report _____

Completion JUN 17 1953Remarks Trapp PoolJ-S-F - Contr.Spudding Date 3-30-53Drig. Data Oil well TD 330415" @ 50 8" @ 2100 Top. 27007" @ 2888 Lans. 3006 TD 33035" @ 3299 Arb. 3294 DD 3304 1000 AComp. 50 bopd

J. G. McGEHEE

Russell KANSAS ✓

Sec. 26 Twp. 15 R. 13W

Well No. 2 Sellens "B" Farm

Jones, Shelburne & Farmer Company

J-S-F - Contr. Contractor

Trapp Pool


990 Ft. from N. Line

Ft. from S. Line

Ft. from E. Line

330 Ft. from W. Line

SW NW NW

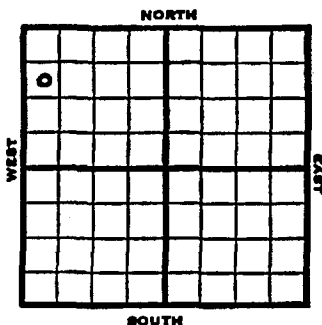

1953	Elev. 1834'	REPORT
4/1	Spud 3-30-53	
4/9	15" @ 50	
	Drlg 1500'	
4/16	Drlg. 2060	
4/23	8" @ 2100	
	Drlg. 2650'	
4/30	Drlg. 2880'	
5/7	Top 2700	
	Fish @ 2830'	
5/21	Recovered fish TD 2888' 7" @ 2888	
5/28	Lans 3006'	
	Drlg 3140'	
6/3	TD 3303'	
	5" @ 3299'	
	CO Arb 3294'	
6/10	N.R.	
6/17	Spud 3-30-53	
	Oil Well	
	TD 3304'	
	15" @ 50'	
	8" @ 2100'	
	Top. 2700	
	7" @ 2888'	
	Lans 3006	
	TD 3303'	
	5" @ 3299'	

OVER

1953

Information brought forward.

6/17 Arb 3294
 DD 3304'
 1000 A
 Comp. 50 bopd.

COMPLETED

Section 26 Township 15 Range 13WWell No. 2 Sellens "B"Company Jones, Shelburne & Farmer