

Kansas

Trapp Pool

Map No. _____ Sec. 27 Twp. 15 R. 13WWell No. 2 W. H. Berry_____
Murfin Drlg. _____ Company_____
NW NW NW _____ Contractor

SECTION PLAT

330 _____ Ft. from N. Line

_____ Ft. from S. Line

_____ Ft. from E. Line

330 _____ Ft. from W. Line

Russell County

Location _____

Rig up _____

Drilling and Remarks:

Spud 1-15-50

8" @ 203 WOC

RECORD

Cased _____ in., _____ ft.

Sand _____

Gas _____

Oil _____

Total Depth _____

PRODUCTION

1st 24 hrs. Nat. _____

1st 24 hrs. after shot _____

Gas _____ Cu. Ft.

Dry Hole _____

Abandoned _____

Date

JAN 18 1950

19

J. E. TYRA Scout

Russell KANSAS

Sec. 27 Twp. 15 R. 13WWell No. #2 W. H. Berry _____ Farm_____
Murfin Drlg. _____ Company

Trapp Pool


330' _____ Ft. from N. Line

_____ Ft. from S. Line

_____ Ft. from E. Line

330' _____ Ft. from W. Line

NW NW NW

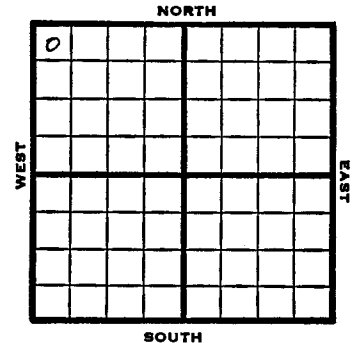

1950

Elev 1869' REPORT

1/18

Spud 1-15-50

8" @ 203'

WOC

3/22

8" @ 203'

Anhy 845'

Topeka 2734'

Heebner 3006'

Dodge 3023'

Lans 3083'

DST 3117-24'

opn 30 mins.

Rec 30' oil cut mud

SO 3170-90

Arb. 3349-69'

5" @ 3359'

TD 3369'

24 shots 3170-78'

144 shots 3174-98'

4000 gcid NS

TD 3425'

SWD

Aband.

ABANDONED

Kansas

Trapp Pool

Map No. _____ Sec. 27 Twp. 15 R. 13W

Well No. 2 W. H. Berry

Murfin Drlg.

Company

NW NE SW

E1. 1869


SECTION PLAT

330 Ft. from N. Line

Ft. from S. Line

Ft. from E. Line

330 Ft. from W. Line

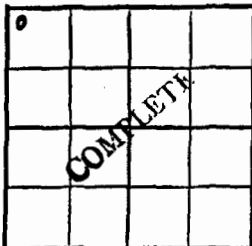

Russell County

Location

Rig up

Drilling and Remarks:

8" @ 203
 anhy 845
 203 2734
 Hillner 3006
 Dodge 3023
 Lane. 3083
 DST 3117-24
 open 30 min.
 Run 30' oil out mud

RECORD

Cased in, ft.

Sand

Gas

Oil

Total Depth

PRODUCTION

1st 24 hrs. Nat.

1st 24 hrs. after shot

Gas Cu. Ft.

Dry Hole

Abandoned

Date

MAH 22 1950 19

J. E. TYRA

Scout

SO 3170-90

Art. 3349-69

5" @ 3359

T.D. 3369

24 shots 3170-78

144 " 3174-78

4000 acit. N.S. 7

T.D. 3425

sws

MAH 22 1950

~~KANS~~

Russell

Section 27 Township 15 Range 13-WWell No. #2 W H BerryCompany Murfin Drlg