

Map No. _____ Sec. 27 Twp. 15 R. 13W

Well No. 1 Berry

Murfin Drlg. _____ Company

Contractor

FIRST REPORT
SECTION PLAT


NE NW

330 Ft. from N. Line

_____ Ft. from S. Line

330 Ft. from E. Line

_____ Ft. from W. Line

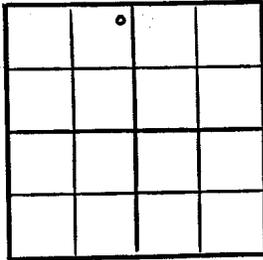

Russell County

Location _____ x

RECORD

Cased _____ in., _____ ft.
Sand _____
Gas _____
Oil _____
Total Depth _____

PRODUCTION

1st 24 hrs. Nat. _____
1st 24 hrs. after shot _____
Gas _____ Cu. Ft.
Dry Hole _____
Abandoned _____

Date

AUG 31 1949 19 S. J. LEWIS Scout

Map No. _____ Sec. 27 Twp. 15 R. 13W

Well No. 1 Berry

Murfin Drlg. _____ Company

COMPLETE

Contractor

NE NW


E.I. 1899
SECTION PLAT

330 Ft. from N. Line

_____ Ft. from S. Line

330 Ft. from E. Line

_____ Ft. from W. Line

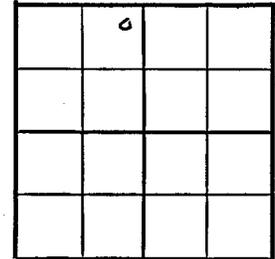

Russell County

Location _____

RECORD

Cased _____ in., _____ ft.
Sand _____
Gas _____
Oil _____
Total Depth 3128

PRODUCTION

1st 24 hrs. Nat. _____
1st 24 hrs. after shot _____
Gas _____ Cu. Ft.
Dry Hole _____
Abandoned _____

Date

DEC 7 1949 19 S. J. LEWIS Scout

*Liama 3049
5' casing
2000 cu. ft.
Prod. 215 oil + 11% w
40% oil*

Russell KANSAS

Sec. 27 Twp. 15 R. 13W

Well No. #1 Berry Farm

Murfin Drlg. Company


Trapp Pool

330' Ft. from N. Line

Ft. from S. Line

330' Ft. from E. Line

Ft. from W. Line

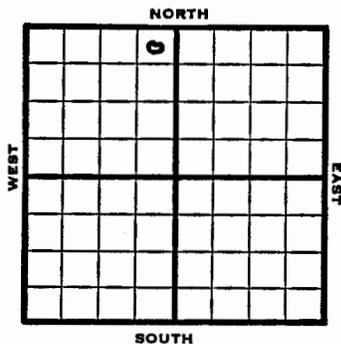

NE NW

1949 Elev. 1849' REPORT

8/31 Location
 9/7 8" @ 226'
 9/14 Drlg 2830'
 9/21 Dodge 2986' Lansing 3049'
 TD 3090'
 5" @ 3079'
 9/28 "
 10/5 3000 acid
 Swb 7 bbls oil / 7 W 8 hrs.
 Drlg 3120'
 10/12 TD 3173'
 10/19 "
 10/26 Estimate 50 bbls oil a day
 11/1 "
 11/9 "
 11/16 2000 acid
 11/23 Pump 116 bbls oil / 18% Wtr 24 hrs.
 11/29 "
 12/7 TD 3173'
 Lansing 3049'
 5" @ 3079'
 2000 acid
 Pump 218 Oil / 11% W Pot
 40^g Gr.
 Comp

COMPLETED

KANSAS

Russell

Section 27 Township 15 Range 13W

Well No. 1 Berry

Company Murfin Drlg.

Trapp
NORTH

