



Sec. 27 Twp. 15 R. 13W

Well No. #1 Berry Farm

C. E. Skiles Company

Contractor

Trapp


Ft. from N. Line

330 Ft. from S. Line

Ft. from E. Line

330 Ft. from W. Line

SW SW SW

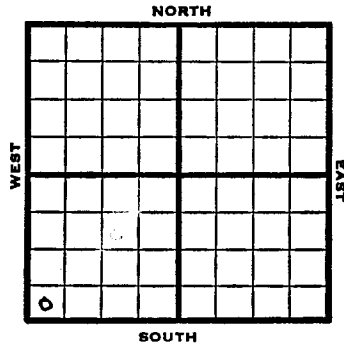


Section 27 Township 15 Range 13 W

Well No. # 1 Berry

Company C. E. Skiles

NORTH

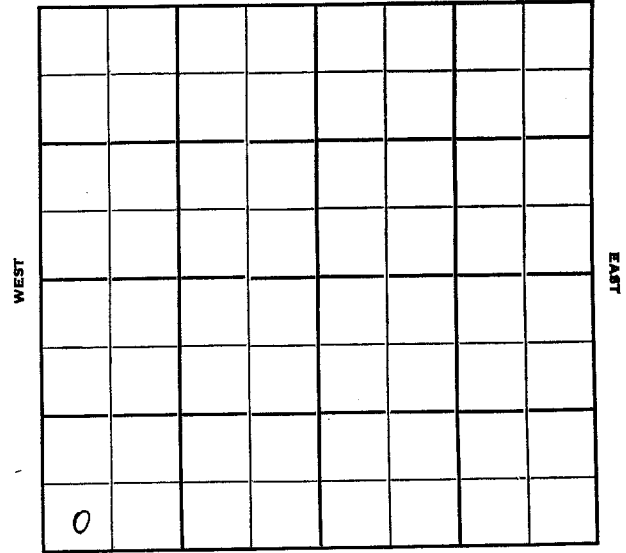

1951 Elev. 1887' REPORT

11/7 Location

1952 1/2 Spud 11-6-51

Oil Well TD 3345

8" @ 278

Lans. 3094 Arb. 3339-44

5" @ 3341 TD 3345

FU 1525' oil 16 hr. S/ 3 BOPH

Comp. 75 BOPD

COMPLETED

424030