

Russell

KANSAS

SEC.	TWP.	R.
27	15	13W

WELL NO. #7 Sellens FARM COMPANY

FORM 513 REV. SUNRAY

County **Russell** Elev. **13W**
 Sec. **27** Twp. **15** Rge. **13W**
 Company **Ray Fleming**
 Farm Name **Sellens** No. **7**

TOPS	DEPTH	LOG	DATUM	Loc. in Sec.
Anh.				NW SE NE
Tr.				
H.				
Tr.				
Dg.				
Bl.				
L.				
K.C.				
B.K.C.				
Ce.				
C.				Geol. Lewis
M.				Contr.
M.				Lewis
K.				Pool
Mz.				Trapp
Me.				
V.				
S.				
S.				
A.				
R.				
Pe.				
G.				
TD.				

Date Comm. **12-29-55**
8" @ 235/125 drlg. 2847

15

Ray Fleming


CONTRACTOR

Lewis

Trapp

_____ Ft. from N. Line
 _____ Ft. from S. Line
 _____ Ft. from E. Line
 _____ Ft. from W. Line

NW SE NE

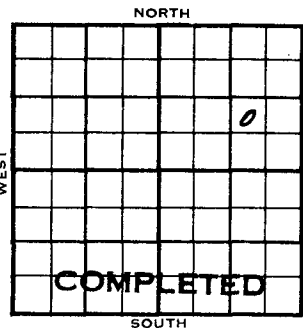

1956	ELEVATION	REPORT
1-5	Comm. 12-29-55 8" @ 235/125 Drlg. 2847'	

County Russell Elev. 834 ^{1841 RD}

Sec. 27 Twp. 15 Rge. 13W

Company Ray Fleming

Farm Name Sellens No. 7

TOPS	DEPTH	LOG	DATUM	Loc in Sec.
Ank				NW SE NE
Tr				
H	2954			
Tr				
Dp				
Bl				
L	3036		1198	Geol. <u>L</u>
N.C.				Locat
B.K.C.				<u>Lewis</u>
Ce.				
C.				Pool
M.				<u>Trapp</u>
M.				
K.				
Mz.				
Me.				
V.				
S.				
S.	13298		1460	
A.				
R.				
PC				COMPLETE
G.				
TD	3310			

Date Comm. 12-29-55 MAR 7 1956

8" @ 235/125 drlg. 2847 JAN 11 '56 DST

3041-61 open 1 hr. 1400' gas

rec. 90' HQ & GCM + 150' SM & GCO

FFP 120# BHP 310/15 DST

3118-38 open 1 hr. rec 34' WM (sprk oil) BHP est 95/15" DST 3307

- 27 open 1 hr. rec 28' Md

BHP 240/15 ^{55%} RTD 3310 no lag

5 1/2 @ 3303/125 WRC JAN 18 '56

CO 3310 tst Mostly wtr PB 3160

64/3044-60 ¹² HVs tst 9. FEB 8 '56 ✓

FEB 15 '56 ✓ FEB 22 '56 POP FEB 29 '56 ✓ MAR 7 '56

\$ 100 Bopd + 1040 wtr

POP P. 40 Bopd + 1540

complete for 25 Bopd

no/w

Russell **KANSAS**

SECTION 27 TOWNSHIP 15 RANGE 13 W

WELL NO. 47 Selleus

COMPANY Ray Fleming

