


County Russell State Kansas
 Sec. 27 (Bk. 15 (Sur. 13W Map No.
 (Twp.) (Rge.)
 Operator Jones, Shelburne & Farmer
 Well No. 2 Farm Sellens "D"
 Elev. Location NW NE SE

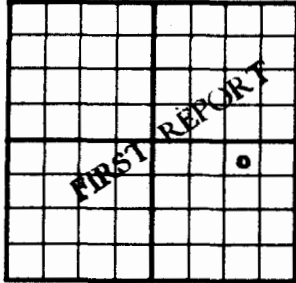


330 Ft. From N Line SE
990 Ft. From E Line Quarter
 1st. Report FEB 11 1953
 Completion
 Remarks
J-S-F - Contr.
 Spudding Date

Drig. Data Trapp Pool
Cellar & pits

J. G. McGEHEE

County Russell State Kansas
 Sec. 27 (Bk. 15 (Sur. 13W Map No.
 (Twp.) (Rge.)
 Operator Jones, Shelburne & Farmer
 Well No. 2 Farm Sellens "D"
 Elev. 1839 Location NW NE SE

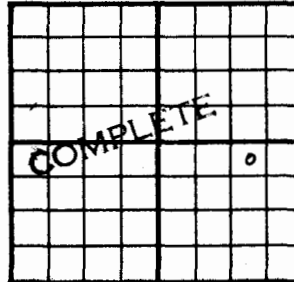

330 Ft. From N Line SE
990 Ft. From E Line Quarter
 1st. Report
 Completion JUN 3 1953
 Remarks Trapp Pool
J-S-F - Contr.
 Spudding Date 3-24-53

Drig. Data Oil well TD 3322
15" @ 450 10" @ 2100 8" @ 2465
7" @ 3056 Top. 2738 KC 3050 Arb. 3317
TD 3320 5" @ 3317 DD 3322 FU 1800' oil
Comp. 45 bopd

J. G. McGEHEE

Russell KANSAS ✓

Sec. 27 Twp. 15 R. 13 WWell No. # 2 Sellens "D" FarmJones, Shelburne & Farmer CompanyJ-S-F Contractor

Trapp Pool


330 Ft. from N. Line

Ft. from S. Line

990 Ft. from E. Line

Ft. from W. Line

NW NE SE

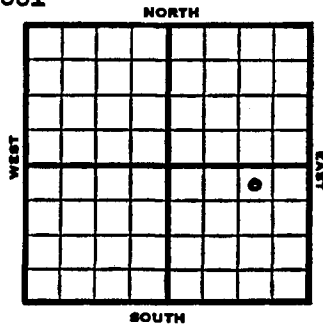1953
6/3

Spud 3-24-53 Oil well TD 3322
 15" @ 450 10" @ 2100 8" @ 2465
 7" @ 3056 Top 2738' KC 3050'
 Arb. 3317' TD 3320' 5" @ 3317
 DD 3322 FU 1800' oil
 Comp. 45 BOPD

COMPLETED

1953	Elev. 1839' REPORT
2/11	Cellar & Pits
2/19	C & P
2/26	RUR
3/12	RUR
3/19	"
3/26	"
4/2	15" @ 450 Drlg. 650'
4/9	Drlg 900'
4/16	Drlg. 2110'
4/23	10" @ 2100 8" @ 2465 Drlg. 2700
4/30	7" @ 3056 Top 2700, KC 3005 Drlg. 3080'
5/7	Arb 3317' TD 3320' 5" @ 3317'
5/21	DD 3322' FU 1800' oil POP
5/28	N.R.
OVER	

FORM 51

Russell

KANSAS

Section 27 Township 15 Range 13W

Well No. #2 Sellens "D"

Company Jones, Shelburne & Farmer

