

Russell

KANSAS

Sec. 27 Twp. 15 R. 13 W

Well No. # 1 Sellens "D" Farm

Jones, Shelborne & Farmer Company

Contractor


330 Ft. from N. Line

Ft. from S. Line

330 Ft. from E. Line

Ft. from W. Line

NE NE SE

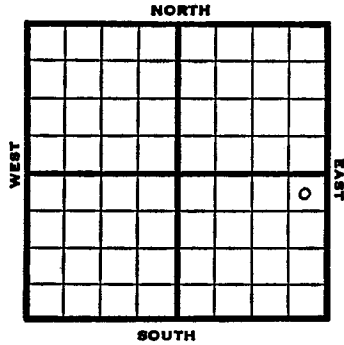


Russell I KANSAS

Section 27 Township 15 Range 13W

Well No. #1 Sellens "D"

Company Jones, Shelborne & Farmer

NORTH

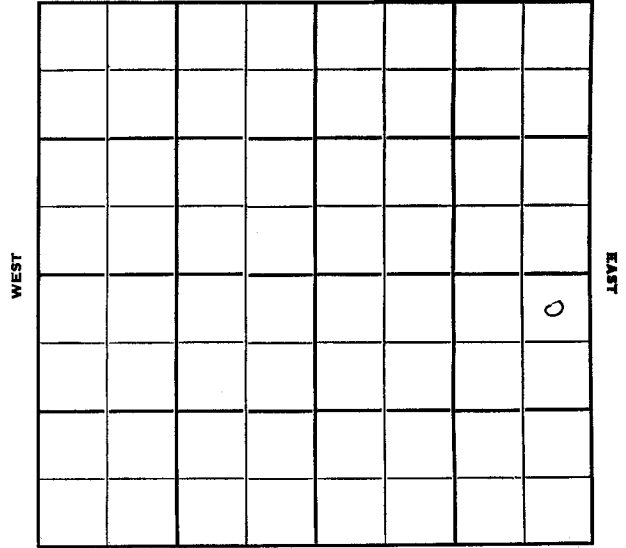

SOUTH

1951	Elev. 1821' REPORT
4/18	Pits
7/25	Spud 5-2-51 Oil well TD 3306' 20" @ 26 15" @ 415 Anhy 784' 13" @ 790 10" @ 2109' Br. lime 3040-46' KC 3052' SSO 3052-60' Arb 3303' 5" @ 3302' TD 3306' S/3 BOPH Comp. 36 BOPD 6 BW
	COMPLETED