

Map No. KANSAS Sec. 28 Twp. 15 R. 18 WWell No. 73Well No. 1 Rude

Signal Oil Company

Contractor

SECTION PLAT

Ft. from N. Line

990 Ft. from S. Line

330 Ft. from E. Line

Ft. from W. Line

FIRST REPORTS

			0

Location ✓

Rig up

Drilling and Remarks:

RECORD

Cased.....in.,ft.

Sand.....

Gas.....

Oil.....

Total Depth.....

PRODUCTION

1st 24 hrs. Nat.....

1st 24 hrs. after shot.....

Gas.....Cu. Ft.

Dry Hole.....

Abandoned.....

Date

OCT 8 1930 LEWIS Scout

Map No. KANSAS Sec. 28 Twp. 15 R. 18 WWell No. 73Well No. 1 Rude

Signal Oil Company

Contractor

SECTION PLAT

Ft. from N. Line

990 Ft. from S. Line

330 Ft. from E. Line

Ft. from W. Line

COMPLETED

			0

Location.....

Rig up.....

Drilling and Remarks:

Oil line 3349-52

Swab 500 yds.

RECORD

Cased.....in.,ft.

Sand.....

Gas.....

Oil.....

Total Depth 3352

PRODUCTION

1st 24 hrs. Nat.....

1st 24 hrs. after shot.....

Gas.....Cu. Ft.

Dry Hole.....

Abandoned.....

Date

JAN 7 1931 S. J. LEWIS Scout

Map No. KANSAS Sec. 28 Twp. 15 R. 13W

Well No. 1-Grude Farm


Signal Oil Company

 Ft. from N. Line

990 Ft. from S. Line

330 Ft. from E. Line

1930 Ft. from W. Line

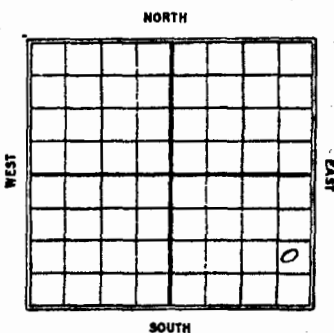

1931
11/7- Silc line 3349-52
TD 3352
swab 500 bbl oil
Comp.

Date	REPORT
10/18	Lgc
10/15	Ply
10/22	
10/29	
11/5	h. Only 410'
11/12	" 815'
11/19	" 1360'
11/26	" 1800'
12/3	2" M. gas 2145-52
	10"-2154
	Dry 2555
12/10	" 2972
12/17	VIR 8"-3045
12/23	show oil & water 3175-80
	Pay 3230-35
	swab 71 bbl oil
	dreg 3309
	2500' oil in hole
12/30	Silc line 3349-50
	had 3100' oil in hole
	swab 280 bbl 14 hr &
	swab down 1000 ft
	only

