

County **Russell** State **Kansas**
 Sec. **28** (Blk. Twp.) **15** (Sur. Rge.) **13W** Map No.
 Operator **B & R Drlg.**
 Well No. **1** Farm **Rude**
 Elev. _____ Location **NW NW SE**

330 Ft. From **N** Line **SE**
330 Ft. From **W** Line Quarter
 Ist. Report **APR 30 1952**
 Completion _____
 Remarks _____
B & R Drlg. - Contr.
 Spudding Date **4-28-52**
 Drlg. Data **Trapp**
8" @ 260 WOC

J. G. McGEHEE

County **Russell** State **Kansas**
 Sec. **28** (Blk. Twp.) **15** (Sur. Rge.) **13W** Map No.
 Operator **B & R Drlg.**
 Well No. **1** Farm **Rude**
 Elev. **1884** Location **NW NW SE**

330 Ft. From **N** Line **SE**
330 Ft. From **W** Line Quarter
 Ist. Report _____
 Completion **MAY 28 1952**
 Remarks **Trapp Pool**
B & R Drlg. - Contr.
 Spudding Date **4-28-52**
 Drlg. Data **D & A TD 3370**
8" @ 260 Anhy 855 Top. 2769
Heeb. 2998 Tor. 3012 KC 3073
DST 3151-83 open 1 hr. Rec. 90' scum
DST 3198-3250 open 1 hr. Rec. 30' mud
Arb. 3348 TD 3351 5" @ 3349 DD 3368
water DD 3370 HFW SP 3300 16/ 3265-
69 500 A S/ 1 gw scum oil ph SP 3220
12/ 3161-65 500 A S/ 1 bw 1 goph
D & A

J. G. McGEHEE

Russell KANSAS

Sec. 28 Twp. 15 R. 13 W

Well No. # 1 Rude Farm

B & R Drlg. Company

B & R Drlg. Contractor

Trapp


330 Ft. from N. Line

Ft. from S. Line

Ft. from E. Line

330 Ft. from W. Line

NW NW SE

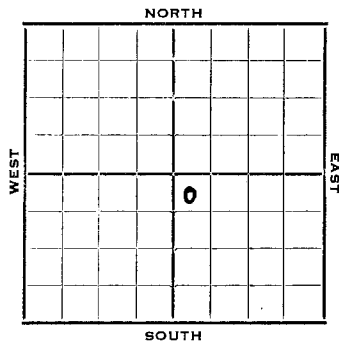


KANSAS

Section 28 Township 15 Range 13W

Well No. #1 Rude

Company B & R Drlg.

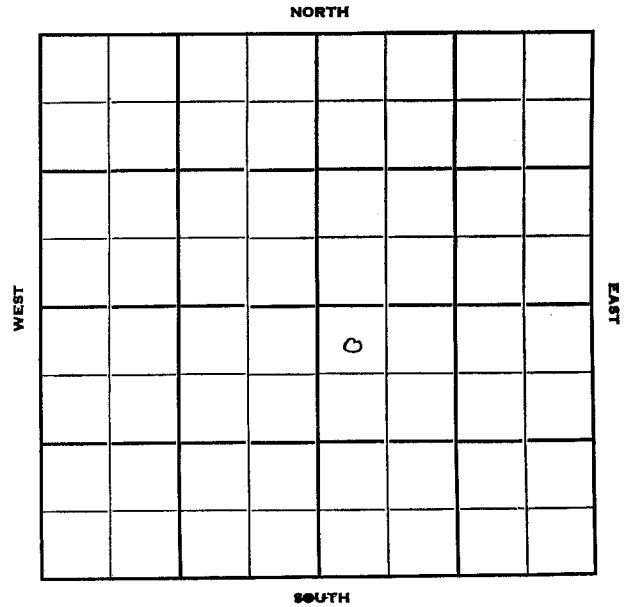

1952 Elev. 1884' REPORT

4/30 Spud 4-28-52
8" @ 260' WOC

5/7 Shut down for repairs 1925'

5/14 Anhy 855' Drlg. 2718'

5/21 Topeka 2769' Heeb 2998' Tor 3012'
KC 3073'
DST 3151-83, 1 hr, 90' SOCM
DST 3198-3250 1 hr, 30' M
Arb. 3348' RTD 3351' 5" @ 3349
WOC

5/28 Spud 4-28-52
D & A TD 3370' 8" @ 260
Anhy 855' Top 2769' Heeb 2998'
Tor. 3012' KC 3073'
DST 3151-83 open 1 hr. rec 90' SOCM
DST 3198-3250 open 1 hr. rec 30' mud
Arb. 3348' TD 3351' 5" @ 3349'
DD 3368 water DD 3370' HFW SP 3300'
16/3265-69 500 A S/1 GW scum oil
PH SP 3220 12/3161-65 500 A
S/1 BW 1 GPH D & A
ABANDONED