

Trapp Pool

Russell County Kansas State
Map No. Sec. 28 Twp. 15 R. 13W
Well No. 2 Hinderliter "A"

Carter Oil Company

FIRST REPORT Contractor

SE NW SW

SECTION PLAT

990 Ft. from N. Line

_____Ft. from S. Line

_____ Ft. from E. Line

990 Ft. from W. Line

Trapp Pool

Remarks:

10" @ 294 Anhy 850 drlg. 1380

Map No. 78 Sec. 28 Twp. 15 R. 13W
Well No. 2 Hinderliter "A"

Carter Oil _____ Company

COMPLETE

Contractor

SE NW SW

E1, 1889
SECTION PLAT

990 Ft. from N. Line

_____ Ft. from S. Line

_____ Ft. from E. Line

990 Ft. from W. Line

Russell County

Location

Rig up.

Drilling and Remarks:

Cr 43337
 2" 43340
 5-00 acid
 Pump 40 oil BX
 + 40% W
 40 2/4

RECORD

Cased _____ in., _____ ft.

Sand _____

Gas _____

Oil _____ ✓

Total Depth 3341

PRODUCTION

1st 24 hrs. Nat. _____

1st 24 hrs. after shot_____

Gas _____ Cu. Ft.

Dry Hole_____

Abandoned_____

Date

Date
AUG 18 1948

Scout S. J. LEWIS

OCT 27 1948 19

S. J. LEWIS

Scout

KANSAS

Russell

Sec. 28 Twp. 15 R. 13WWell No. #2 Hinderliter "A" Farm _____

Carter Oil Company

Trapp Pool


990' Ft. from N. Line

Ft. from S. Line

Ft. from E. Line

990' Ft. from W. Line

SE NW SW

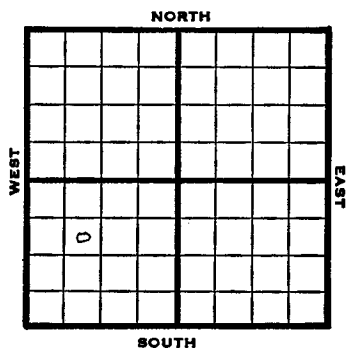

1948

Eli 1889' REPORT

8/18 10" @ 284'
Anhy. 850'
Drlg. 1380'

8/25 Lansing 3102'
Drlg 3283'

9/1 Arbuckle 3337-41 TD
7" @ 3340'

9/8 500 acid
Swb 297 bbls oil 13 hrs.

9/14 " "

9/21 " "

9/29 Pump 525 bbls oil 24 hrs.

10/6 " "

10/13 " "

10/19 " "

10/27 TD 3341'
Arb. 3337'
7" @ 3340
500 acid
Pump 40 oil Pot / 10% W
409 Gr.
Comp
COMPLETED

KANSAS Russell

Section 28 Township 15 Range 13WWell No. 2 Hinderliter "A"Company Carter Oil

Trapp Pool

