

Map No. _____ Sec. 28 Twp. 15 R. 13W

Well No. 2 Hinderliter

Fred Smith etal. _____ Company

FIRST REPORT _____ Contractor

NE SW SW

SECTION PLAT

_____ Ft. from N. Line

990 _____ Ft. from S. Line

_____ Ft. from E. Line

990 _____ Ft. from W. Line

Russell County

Location _____

Rig up _____

Drilling and Remarks:

R U R

RECORD

Cased _____ in., _____ ft.

Sand _____

Gas _____

Oil _____

Total Depth _____

PRODUCTION

1st 24 hrs. Nat. _____

1st 24 hrs. after shot _____

Gas _____ Cu. Ft.

Dry Hole _____

Abandoned _____

Date

OCT 6 1948 19 _____ S. J. LEWIS Scout

Map No. 73 Sec. 28 Twp. 15 R. 13W

Well No. 2 Hinderliter

Fred Smith etal. _____ Company

ABANDONED

Contractor

NE SW SW

SECTION PLAT

_____ Ft. from N. Line

990 _____ Ft. from S. Line

_____ Ft. from E. Line

990 _____ Ft. from W. Line

Russell County

Location _____

Rig up _____

Drilling and Remarks:

See 7341

RECORD

Cased _____ in., _____ ft.

Sand _____

Gas _____

Oil _____

Total Depth 8848

PRODUCTION

1st 24 hrs. Nat. _____

1st 24 hrs. after shot _____

Gas _____ Cu. Ft.

Dry Hole _____

Abandoned _____

Date

DEC 8 1948 19 _____ S. J. LEWIS Scout

KANSAS Russell

Sec. 28 Twp. 15 R. 13-W ✓

Well No. #2 Hinderliter Farm

Fred Smith et al Company

Trapp


Ft. from N. Line

990 Ft. from S. Line

Ft. from E. Line

990 Ft. from W. Line

NE SW SW

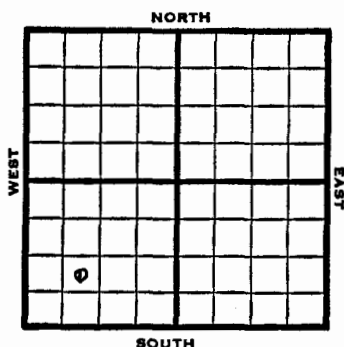

1948 Eli 1891' REPORT

10/6 RUR

10/13 8" @ 285'
rlg 1690'

10/19 Drlg 2550'
10/26 Topeka 2770'

Lansing 3074

Arb. 3341'

TD 3343

5" @ 3341'

11/3 1300 acid 24 B fluid PH 12 hrs.
mostly Wtr PB

11/10 "

11/16 "

11/23 "

11/30 "

12/8 TD 3343'

Arb 3341'

Aband.

ABANDONED

KANSAS Russell

Section 28 Township 15 Range 13W

Well No. 2 Hinderliter

Company Fred Smith et al

Trapp Pool

