

Map No. _____ Sec. 28 Twp. 15 R. 13W

Well No. 1 Henderliter

Fred Smith et al. _____ Company

FIRST REPORT _____ Contractor

NW SW SW

SECTION PLAT

_____ Ft. from N. Line

990 _____ Ft. from S. Line

_____ Ft. from E. Line

330 _____ Ft. from W. Line

Russell County

Location _____

Rig up _____

Drilling and Remarks:

R U R

RECORD

Cased _____ in., _____ ft.

Sand _____

Gas _____

Oil _____

Total Depth _____

PRODUCTION

1st 24 hrs. Nat. _____

1st 24 hrs. after shot _____

Gas _____ Cu. Ft.

Dry Hole _____

Abandoned _____

Date

JAN 14 1948 19

S. J. LEWIS

Scout

Map No. 73 Sec. 28 Twp. 15 R. 13W

Well No. 1 Henderliter

Fred Smith et al. _____ Company

COMPLETE _____ Contractor

NW SW SW

SECTION PLAT

_____ Ft. from N. Line

990 _____ Ft. from S. Line

_____ Ft. from E. Line

330 _____ Ft. from W. Line

Russell County

Location _____

Rig up _____

Drilling and Remarks:

Cased 330'

5" casing

Pump 345' oil +

12 1/2" oil

40 1/2"

RECORD

Cased _____ in., _____ ft.

Sand _____

Gas _____

Oil _____

Total Depth 330'

PRODUCTION

1st 24 hrs. Nat. _____

1st 24 hrs. after shot _____

Gas _____ Cu. Ft.

Dry Hole _____

Abandoned _____

Date

APR 21 1948 19

S. J. LEWIS

Scout

KANSAS Russell

Sec. 28 Twp. 15 R. 13W

Well No. #1 Hendesliter Farm


Fred Smith et al Company
Trapp

Ft. from N. Line

990 Ft. from S. Line

Ft. from E. Line

330 Ft. from W. Line

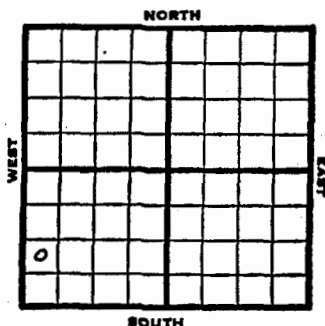

NW SW SW

Elev. 1889' REPORT

1948

1/14 RUR

1/21 8" @ 254'
Drlg. 2163'

1/26 Lansing 306 9'
Arbuckle 3333'-35'
TD 3335'
3D@ 3333'
RUST

2/4 "

2/11 TD 3336'
2600' oil 12 hrs.

2/18 "

2/25 Pump 8 bbls oil PH, 19 hrs.

3/3 "

3/10 "

3/17 "

3/24 Pump 8 bbls oil PH 30 hrs.

3/31 "

4/7 "

4/14 "

OVER

1948
4/21

Arbuckle 3333'

5" @ 3333'

Pump 345 Oil & 12% W Pot.

Gr. 40.9

TD 3336'

COMPLETED

KANSAS**Russell**Section 28 Township 15 Range 13WWell No. #1 HendesliterCompany Fred Smith etal.