

County **Russell** State **Kansas**  
 Sec. **28** (Blk. **15**) (Sur. **13W**) Map No.  
 Operator **Harms & Knight**  
 Well No. **1** Farm **Dietz**  
 Elev. Location **NW NW NW**

|   |  |  |  |  |  |
|---|--|--|--|--|--|
| 0 |  |  |  |  |  |
|   |  |  |  |  |  |
|   |  |  |  |  |  |
**530** Ft. From **N** Line **NW**  
**530** Ft. From **W** Line Quarter  
 Ist. Report **MAY 16 1951**  
 Completion  
 Remarks  
 Spudding Date

**FIRST REPORT**

Drlg. Data **Trapp Pool**

**drlg.**

**J. E. TYRA**

County **Russell** State **Kansas**  
 Sec. **28** (Blk. **15**) (Sur. **13W**) Map No.  
 Operator **Harms & Knight**  
 Well No. **1** Farm **Dietz**  
 Elev. **1886** Location **NW NW NW**

|   |  |  |  |  |  |
|---|--|--|--|--|--|
| 0 |  |  |  |  |  |
|   |  |  |  |  |  |
|   |  |  |  |  |  |
**330** Ft. From **N** Line **NW**  
**330** Ft. From **W** Line Quarter  
 Ist. Report  
 Completion **JUN 20 1951**  
 Remarks **Trapp Pool**  
 Spudding Date

**COMPLETE**

Drlg. Data **Oil well TD 3165**

**Heeb. 2997 Lans. 3067 DST 3095-3110**  
**open 45 min. Rec. 30' socm 5" @ 3095**  
**TD 3110 1000 A test 5 1/2 bo 14 bw 14 hr.**  
**DD 3139 2500 A S/ 21 bo 29 bw 18 hr.**  
**TD 3165 1000 A Comp. 21 bopd 50% water**

**J. E. TYRA**

Russell  
15

**KANSAS**  
13W

Sec. 28 Twp. R.

Well No. #1 Dietz Farm

Harms & Knight Company

Trapp Pool Contractor


30' Ft. from N. Line

Ft. from S. Line

Ft. from E. Line

330' Ft. from W. Line


NW NW NW

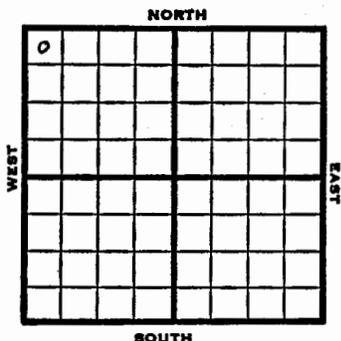

Section 28 Township 15 **KANSAS** Range 13W

Well No. #1 Dietz

Company Harms & Knight

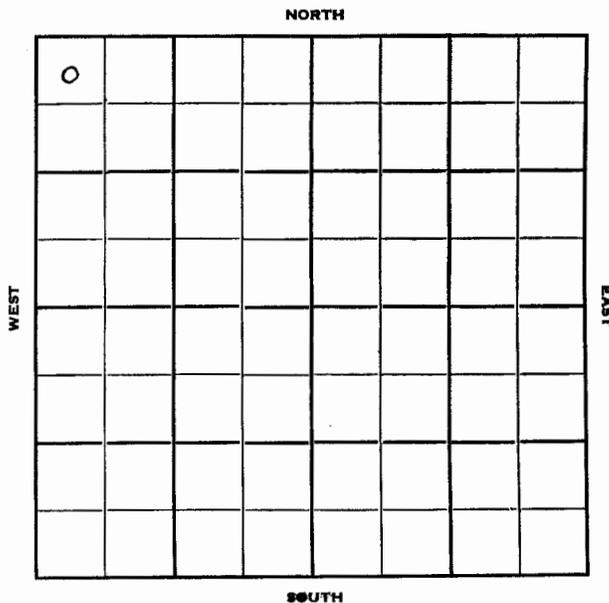

1951 Elev. 1886' **REPORT**

5/16 Drlg.  
6/20 Oil Well TD 3165  
Heeb. 2997 Lans. 3067  
DST 3095-3110 opn 45 mins.  
Rec. 30' socm 5" @ 3095  
TD 3110 1000 A Test 5½ bo 14 bw  
14 hr. DD 3139 2500 A  
S/21 bo 29 bw 18 hr.  
TD 3165 1000 A Comp. 21 bopd  
50% wtr.

**COMPLETE**