


KANSAS Kansas Pool Name TrappMap No. 73 Sec. 28 Twp. 15 R. 13WWell No. 3 DietzBlack-Marshall Company

FIRST REPORT

Contractor

NW SE NW

SECTION PLAT

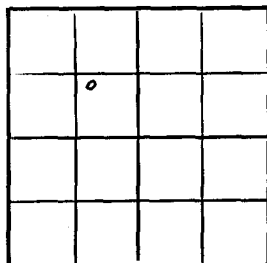

Ft. from N. Line

990 Ft. from S. Line990 Ft. from E. Line

Ft. from W. Line

Russell County

RECORD

Location XCased in ft.Sand Gas Oil Total Depth

PRODUCTION

1st 24 hrs. Nat. 1st 24 hrs. after shot Gas Cu. Ft.Dry Hole Abandoned

Date

AUG 8 1946

19

S. J. LEWIS

Scout


KANSAS Trapp Pool
KansasMap No. 73 Sec. 28 Twp. 15 R. 13WWell No. 3 DietzBlack-Marshall Company

COMPLETED

Contractor

NW SE NW

SECTION PLAT

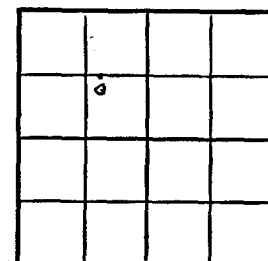

Ft. from N. Line

990 Ft. from S. Line990 Ft. from E. Line

Ft. from W. Line

Russell County

RECORD

Location Cased in ft.Sand Gas Oil Total Depth

PRODUCTION

1st 24 hrs. Nat. 1st 24 hrs. after shot Gas Cu. Ft.Dry Hole Abandoned

Date

OCT 16 1946

19

S. J. LEWIS


Scout

KANSAS

Russell County

Sec. 28 Twp. 15 R. 13WWell No. #3 Dietz FarmBlack-Marshall Company

Trapp

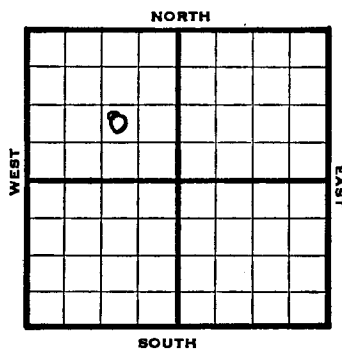 Ft. from N. Line990 Ft. from S. Line990 Ft. from E. Line Ft. from W. Line

NW SE NW

1946 1872 REPORT

8/28 Location

9/5 "

9/10 RUR

9/18 8" @ 315'

Anhy 8213'

Drlg 2760'

9/24 Topeka 2770'

Lans 3062

Arb 3347'

TD 3349'

5" @ 3349' RUST

10/1 " "

10/8 TD 3357

Pump 25 oil in 3 hrs

10/16 Arb 3347'

5" @ 3349'

TD 3357'

Pump 200 POT

Grav. 40.9

COMPLETED

KANSAS

Russell county

Section 28 Township 15 Range 13-WWell No. #3, DietzCompany Black-Marshall