

Russell KANSAS

Map No. 73 Sec. 29 Twp. 15 R. 13WWell No. 4 Chester Sellens

Southern

Company

Contractor

FIRST REPORT

SE NW

Ft. from N. Line

330 Ft. from S. Line330 Ft. from E. Line

Ft. from W. Line

TRAPP POOL

SECTION PLAT

Location

Rig up

Drilling and Remarks:

Rotary
8" @ 251

Drlg. 1715

RECORD

Cased in. ft.

Sand

Gas

Oil

Total Depth

PRODUCTION

1st 24 hrs. Nat.

1st 24 hrs. after shot

Gas Cu. Ft.

Dry Hole

Abandoned

Date

19

Scout

KANSAS

Russell

Map No. 73 Sec. 29 Twp. 15 R. 13WWell No. 4 Chester Sellens

Southern

Company

Contractor

SECTION PLAT

Ft. from N. Line

330 Ft. from S. Line330 Ft. from E. Line

Ft. from W. Line

Trapp Pool

Location

Rig up

Drilling and Remarks:

Ar 3324

5" @ 3324

1000 acid

Minimum Well

15 x 4 1/2

RECORD

Cased in. ft.

Sand

Gas

Oil

Total Depth 3328 1/2

PRODUCTION

1st 24 hrs. Nat.

1st 24 hrs. after shot

Gas Cu. Ft.

Dry Hole

Abandoned

Date

AUG 23 1939 19

S. J. LEWIS

Scout

Sec. 29 Twp. 15 R. 13-W

Well No. #4 Chester Sellens Farm

Southern _____ Company

(Trapp)

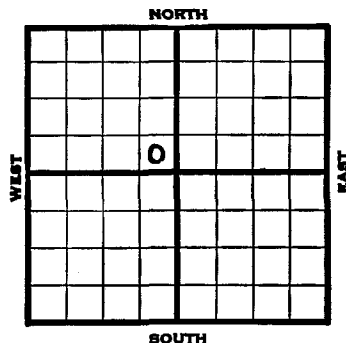
Ft. from N. Line

330 Ft. from S. Line

330 Ft. from E. Line

Ft. from W. Line

Elev. 1883

[illegible]

Section 29 Township 15 Range 13-W

Well No. #4 Chester Sellens

Southern
Company

NORTH

