


KANSAS

County **Russell** State **Kansas**
 Sec. **27** (Blk. Twp.) **15** (Sur. Rge.) **13W** Map No.
 Operator **Jones, Shelburne & Farmer**
 Well No. **1** Farm **Chester Sellens**
 Elev. Location **NE SE NW**

Map No. _____ Sec. **29** Twp. **15** R. **13W**
 Well No. **1** **Chester Sellens**
Jones, Shelburne & Farmer Company
CORRECTION Contractor

990 Ft. From **S** Line **NW**
330 Ft. From **E** Line **Quarter**
 Ist. Report **DEC 10 1952**
 Completion _____
 Remarks _____
 Spudding Date _____

C E $\frac{1}{2}$ E $\frac{1}{2}$ NW
 _____ Ft. from N. Line
1320 Ft. from S. Line
330 Ft. from E. Line
 _____ Ft. from W. Line

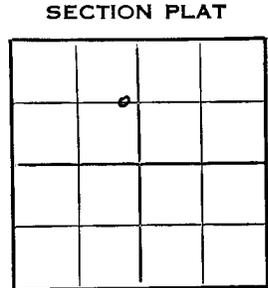

Orig. Data
RUCT

Russell County


RECORD	
Cased _____ in., _____ ft.	
Sand _____	
Gas _____	
Oil _____	
Total Depth _____	
PRODUCTION	
1st 24 hrs. Nat. _____	
1st 24 hrs. after shot _____	
Gas _____ Cu. Ft.	
Dry Hole _____	
Abandoned _____	

Date _____
Reported
27-15-13W
NE SE NW
hook up
FEB 11 1953 19 _____ **J. G. McGEHEE** Scout

J. G. McGEHEE


County Russell State KANSAS
 Sec. 29 (Blk. 15) (Sur. 13W) Map No.
 Operator Jones, Shelburne & Farmer
 Well No. 1 Farm Chester Sellens
 Elev. 1890 Location C E 1/2 E 1/2 NW

Sec. 29 29 Twp. 15 R. 13 W
 Well No. # 1 Chester Sellens Farm
Jones, Shelburne & Farmer Company
 Contractor

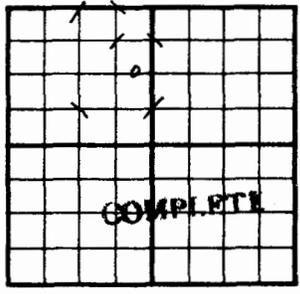

1320 Ft. From S Line NW
330 Ft. From E Line Quarter
 1st. Report
 Completion FEB 11 1953
 Remarks
 Spudding Date

1320 Ft. from N. Line
~~990~~ Ft. from S. Line
330 Ft. from E. Line
 Ft. from W. Line
C E/2 E/2 NW
~~NE SE NW~~

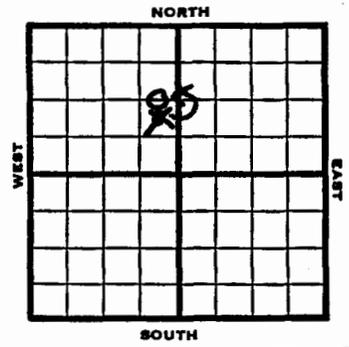

Drig. Data Oil well TD 3350
Anhy 880 Lans. 3075 Arb. 3342 TD 3347
5" @ 3342 DD 3350 FU 600' oil 6 hr.
Comp. 100 bopd 4% wtr.

1952	Elev. 1890' REPORT
12/10	RUCT
12/11	RUST
12/18	Ø860
12/25	" "
1/1	NR
1/8	Ø2900
1/22	Lans. 3075' Arb. 3342' RTD 3347 5" @ 3342 DD 3350 FU 600' oil 6 hr
1/29	NR
2/5	NR
2/11	OilWell TD 3350 Anhy 880, Lans 3075, Arb 3342, TD 3347 5" @ 3342 DD 3350, FU 600' oil 6 hrs. Comp. 100 bopd 4% wtr.

J. G. [unclear]

COMPLETED

Section ~~27~~ ²⁹ Township 15 Range 13W

Well No. 1 Chester Sellens

Company Jones, Shelburne & Farmer

