

Russell KANSAS

Map No. 73 Sec. 29 Twp. 15 R. 13W

Well No. 5 Sellens, estate

Coralena Oil Company

Contractor

FIRST REPORT

SECTION PLAT

SE SW SE

Ft. from N. Line

330 Ft. from S. Line

Ft. from E. Line

990 Ft. from W. Line

TRAPP POOL

Location X

RECORD

Cased in. ft.

Sand

Gas

Oil

Total Depth

PRODUCTION

1st 24 hrs. Nat.

1st 24 hrs. after shot

Gas Cu. Ft.

Dry Hole

Abandoned

Date MAY 17 1939 19

S. J. LEWIS Scout

Russell KANSAS

Map No. 73 Sec. 29 Twp. 15 R. 13W

Well No. 5 Sellens Est.

Coralena Oil Company

Contractor

COMPLETED

SECTION PLAT

SE SW SE

Ft. from N. Line

330 Ft. from S. Line

Ft. from E. Line

990 Ft. from W. Line

TRAPP POOL

Location

RECORD

Cased in. ft.

Sand

Gas

Oil

Total Depth 3306

PRODUCTION

1st 24 hrs. Nat.

1st 24 hrs. after shot

Gas Cu. Ft.

Dry Hole

Abandoned

Per 8363
7" @ 3304 1/2
Echometer Pt
1940
2000 acid

Date JUN 2 1939 19

S. J. LEWIS Scout

Sec. 29 Twp. 15 R. 13-W

Well No. #5 Sellens, Estate Farm
Coralena Oil Company

(Trapp)


_____ Ft. from N. Line

330 Ft. from S. Line

_____ Ft. from E. Line

990 Ft. from W. Line

Elev. 1864

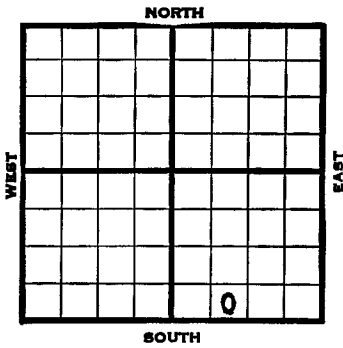

1939	REPORT
5/17	Location
5/26	Rotary rig.
6/1	10" - 244' Drlg. 500'
6/8	Drlg. 2885'
6/16	Arb. 3303' 7" - 3304½'
	T.D. 3305' S.O. Bailing mud.
6/23	T.D. 3306' 2000 acid.
	Pump 80.4 bb1s. oil 11 hrs.
6/28	Arb. 3303'
	7" - 3304½'
	T.D. 3306'
	2000 acid.
	Echometer potential 1940 bb1s.
	COMPLETED

Section 29 Township 15 Range 13-W

Well No. 5 Sellens, estate

Company Coralena Oil

