

Russell KANSAS

Map No. 73 Sec. 29 Twp. 15 R. 13WWell No. 2 Sellens Est.Coralena

Company

Contractor

FIRST REPORT

NW SW SE

Ft. from N. Line

990 Ft. from S. Line

Ft. from E. Line

330 Ft. from W. Line

SECTION PLAT

Location

Rig up

Drilling and Remarks:

Mat.

RECORD

Cased 8 in., 3304 ft.

Sand

Gas

Oil

Total Depth

PRODUCTION

1st 24 hrs. Nat.

1st 24 hrs. after shot

Gas 90 Cu. Ft.

Dry Hole

Abandoned

Date

APR 27 1938 19H. D. Hatfield

Scout

Russell KANSAS

Map No. 73 Sec. 29 Twp. 15 R. 13WWell No. 2 Sellens EstCoralena

Company

Contractor

COMPLETED

NW SW SE

Ft. from N. Line

990 Ft. from S. Line

Ft. from E. Line

330 Ft. from W. Line

SECTION PLAT

Location

Rig up

Drilling and Remarks:

RECORD

Cased 8 in., 3304 ft.Sand Arb 3304

Gas

Oil

Total Depth 3307

PRODUCTION

1st 24 hrs. Nat.

1st 24 hrs. after shot

Gas 90 Cu. Ft.

Dry Hole

Abandoned

Date

JUN 15 1938 19H. D. Hatfield Scout

KANSAS

Russell

Sec. 29 Twp. 15 R. 13-WWell No. #2 Sellens Estate FarmCoralena Company


Ft. from N. Line

990 Ft. from S. Line

Ft. from E. Line

330 Ft. from W. Line

Elev. 1868

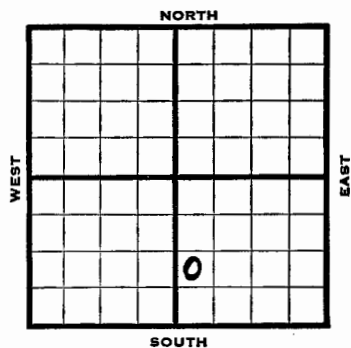

REPORT

1938

4/27 Mat'l.

5/6 R. R.

5/12 "

5/20 13" @ 494'.

Drlg. 813'.

5/27 Drlg. 2715'.

6/3 Arb. 3304-07' T.D. S. O.

8" @ 3304'. RUST.

6/10 " " " "

6/15 8" @ 3304'.

Arb. 3304'.

T.D. 3307'.

Potential 2199 bbls., Nat'l.

COMPLETED

Russell

KANSAS

Section 29 Township 15 Range 13-WWell No. 2 Sellens Est.Company Coralena