

Map No. 72 Sec. 29 Twp. 15 R. 13W

Well No. 5 Sellens Heirs "C"

Southern Company

Contractor

FIRST REPORT

SECTION PLAT

C E L N E S E

660 Ft. from N. Line

_____ Ft. from S. Line

330 Ft. from E. Line

_____ Ft. from W. Line

			o

TRAPP POOL

Location _____

Rig up _____

Drilling and Remarks:

Cellar

RECORD

Cased _____ in., _____ ft.

Sand _____

Gas _____

Oil _____

Total Depth _____

PRODUCTION

1st 24 hrs. Nat. _____

1st 24 hrs. after shot _____

Gas _____ Cu. Ft.

Dry Hole _____

Abandoned _____

Date

JUN 12 1940 19

S. J. LEWIS Scout

Map No. _____ Sec. 29 Twp. 15 R. 13W

Well No. 5 Sellens Heirs "C"

Southern Company

Contractor

COMPLETED

SECTION PLAT

C E L N E S E

660 Ft. from N. Line

_____ Ft. from S. Line

330 Ft. from E. Line

_____ Ft. from W. Line

			o

TRAPP POOL

Location _____

Rig up _____

Drilling and Remarks:

at 8335

5' 10" 3335

1000 cu. ft.

Geological Dept

5091

Net 3000

RECORD

Cased _____ in., _____ ft.

Sand _____

Gas _____

Oil _____

Total Depth 3340

PRODUCTION

1st 24 hrs. Nat. _____

1st 24 hrs. after shot _____

Gas _____ Cu. Ft.

Dry Hole _____

Abandoned _____

Date

JUL 17 1940 19

S. J. LEWIS Scout

Sec. 29 Twp. 15 R. 13-W

Well No. #5 Sellens Heirs "C" Farm

Southern Company

(Trapp)


660 Ft. from N. Line

_____ Ft. from S. Line

330 Ft. from E. Line

_____ Ft. from W. Line

Elev. 1882

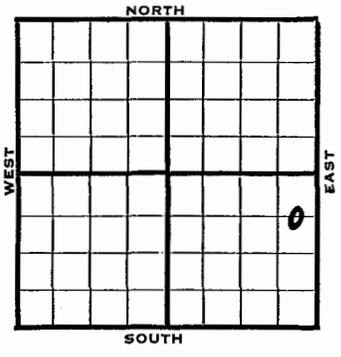

1940	REPORT
6/12	Cellar.
6/20	Derrick.
6/27	13" - 278' Drlg. 1680'
7/3	Drlg. 2875'
7/11	Arb. 3335' T.D. 3337'
	5" - 3335' RUST.
7/17	Arb. 3335'
	5" - 3335'
	T.D. 3340'
	1000 acid.
	Depthograph potential 8091 bbls.
	Maximum 3000 bbls.
	COMPLETED

Section 29 Township 15 Range 13-W

Well No. #5 Sellens Heirs "C"

Company Southern

NORTH **Trapp Pool**

