

KANSAS Russell

Map No. 73 Sec. 30 Twp. 15 R. 13WWell No. 4 SellensEmpire Company

Contractor

SECTION PLAT

	0		

330 Ft. from N. Line

_____ Ft. from S. Line

_____ Ft. from E. Line

990 Ft. from W. Line

FIRST REPORT

Location ✓

Rig up

Drilling and Remarks:

RECORD

Cased _____ in., _____ ft.

Sand _____

Gas _____

Oil _____

Total Depth _____

PRODUCTION

1st 24 hrs. Nat. _____

1st 24 hrs. after shot _____

Gas _____ Cu. Ft.

Dry Hole _____

Abandoned _____

Date

MAR 24 1937 19

S. J. LEWIS Scout

KANSAS Russell

Map No. 73 Sec. 30 Twp. 15 R. 13WWell No. 4 - SellensEmpire Company

Contractor

COMPLETED

SECTION PLAT

	0		

330 Ft. from N. Line

_____ Ft. from S. Line

_____ Ft. from E. Line

990 Ft. from W. Line

Location _____

Rig up

Drilling and Remarks:

4000 APat 2528

RECORD

Cased _____ in., _____ ft.

Sand 511 3284

Gas _____

Oil _____

Total Depth 3288

PRODUCTION

1st 24 hrs. Nat. _____

1st 24 hrs. after shot _____

Gas _____ Cu. Ft.

Dry Hole _____

Abandoned _____

Date

MAY 5 - 1937

19

H. D. Hatfield Scout

KANSAS

Russell

Sec. 30 Twp. 15 R. 13-WWell No. #4 Sellens FarmEmpire

Company


330 Ft. from N. Line

Ft. from S. Line

Ft. from E. Line

990 Ft. from W. Line

Elev. 1853

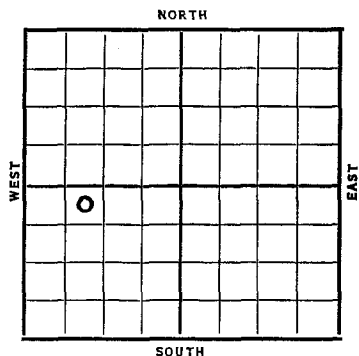

Date REPORT

1937

3/24 Location

4/2 Rig

4/8 10" @ 314' Drlg. 1005'

4/16 Drlg. 2630'.

4/23 Sil. 3284' set 7". WOC.

4/30 T.D. 3288'. Hole full oil.

No test.

5/5 Sil. 3284'.

T.D. 3288'.

4000 A

Pot. 2528.

COMPLETED

KANSAS Russell

Section 30 Township 15 Range 13-WWell Number 4 SellensCompany Empire