

Russell KANSAS

Map No.

Sec. 30

Twp. 15

R. 13 W

Well No.

7 - Boomhower "A"

Southern

Company

Contractor

FIRST REPORT

SECTION PLAT

			0

Ft. from N. Line

990 Ft. from S. Line

990 Ft. from E. Line

Ft. from W. Line

Location

Rig up

Drilling and Remarks:

R.R.

RECORD

Cased in., ft.

Sand

Gas

Oil

Total Depth

PRODUCTION

1st 24 hrs. Nat.

1st 24 hrs. after shot

Gas Cu. Ft.

Dry Hole

Abandoned

Date

MAY 26 1937

19

H. D. Hatfield

Scout

Russell KANSAS

Map No.

Sec. 30

Twp. 15

R. 13 W

Well No.

7 - Boomhower "A"

Southern

Company

Contractor

COMPLETED

SECTION PLAT

			0

Ft. from N. Line

990 Ft. from S. Line

990 Ft. from E. Line

Ft. from W. Line

Location

Rig up

Drilling and Remarks:

2000 A

Pat - 2224

Date

JUL 7 1937

19

H. D. Hatfield

Scout

RECORD

Cased 7" 2893 in., ft.

Sand 5 1/2" 3242

Gas

Oil

Total Depth 3245

PRODUCTION

1st 24 hrs. Nat.

1st 24 hrs. after shot

Gas Cu. Ft.

Dry Hole

Abandoned

KANSAS

Russell


Sec. 30 Twp. 15 R. 13-WWell No. #7 Boomhower "A" FarmSouthern Company

Ft. from N. Line

990 Ft. from S. Line990 Ft. from E. Line

Ft. from W. Line

Elev. 1804

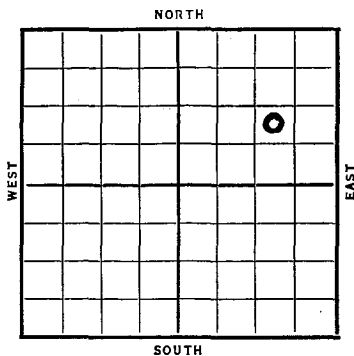

Date REPORT

1937

5/26 R.R.

6/4 10" @ 250'. Drlg. 1030'.

6/11 Drlg. 2415'.

6/19 Osw. & 7" @ 2995'. RUST.

6/25 Drlg. 3190'.

7/2 Sil. 3242' T.D. 268' of 5"
liner. WOC.

7/7 7" @ 2995'.

5" liner 3242'.

Sil. 3242'.

T.D. 3245'.

2000 A.

Pot. 2224 bbls.

COMPLETED

Russell KANSAS

Form 51-5M 5-37 Petrol

Section 30 Township 15 Range 13-WWell No. 7 - Boomhower "A"Company Southern