

Russell KANSAS

Map No. 73 Sec. 30 Twp. 15 R. 13W

Well No. 7-Hank Sellens

Coralena Oil Company

Contractor

FIRST REPORT

SECTION PLAT

330 NW NE NW
Ft. from N. Line
Ft. from S. Line
990 Ft. from E. Line
Ft. from W. Line

0			

Location _____

Rig up _____

Drilling and Remarks:

RR

RECORD

Cased _____ in., _____ ft.
Sand _____
Gas _____
Oil _____
Total Depth _____

PRODUCTION

1st 24 hrs. Nat. _____
1st 24 hrs. after shot _____
Gas _____ Cu. Ft.
Dry Hole _____
Abandoned _____

Date

SEP 29 1937 19 H. D. Hatfield Scout

Russell KANSAS

Map No. _____ Sec. 30 Twp. 15 R. 13W

Well No. 7 Hank Sellens

Coralena Oil Company

Contractor

COMPLETED

SECTION PLAT

330 NW NE NW
Ft. from N. Line
Ft. from S. Line
990 Ft. from E. Line
Ft. from W. Line

0			

Location _____

Rig up _____

Drilling and Remarks:

2500 acid
2000

POT 1544

RECORD

Cased 8 in., 3312 ft.
Sand 51 3312
Gas _____
Oil _____
Total Depth 3314

PRODUCTION

1st 24 hrs. Nat. _____
1st 24 hrs. after shot _____
Gas _____ Cu. Ft.
Dry Hole _____
Abandoned _____

Date

NOV 10 1937 19 H. D. Hatfield Scout

Sec. 30 Twp. 15 R. 13-W

Well No. #7 Hank Sellens Farm


Coralena Oil Company

330 Ft. from N. Line

_____ Ft. from S. Line

990 Ft. from E. Line


_____ Ft. from W. Line

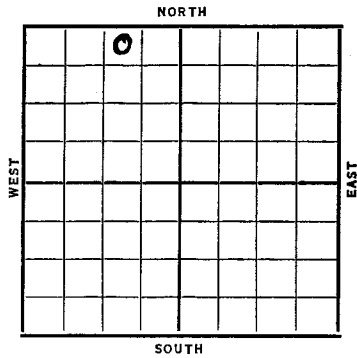

Section 30 Township 15 Range 13-W

Well No. 7 Hank Sellens

Company Coralena Oil

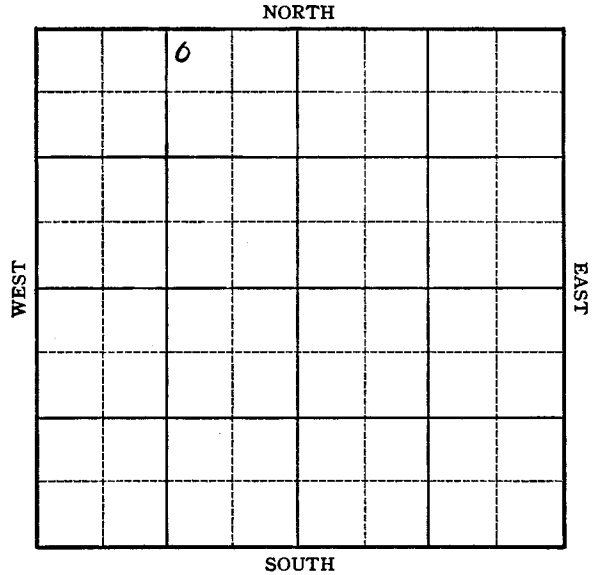

Date	REPORT
1937	
9/29	R.R.
10/8	12" @ 504'. Drlg. 1415'.
10/15	Drlg. 2985'.
10/22	Sil. 3312 & 8". T.D. 3314'. RUST. No shows reported.
10/29	700' oil 3 hrs. 2500 acid.
11/5	" " " " "
11/10	8" @ 3312'. Sil. 3312'. T.D. 3314'. 2500 acid. 2000 acid. Potential 1544 bbls.
	COMPLETED