

Russell KANSAS

Map No. \_\_\_\_\_ Sec. 30 Twp. 15 R. 13W

Well No. 3-H. Sellens

Coralena Company

Contractor

FIRST REPORT

SECTION PLAT

990 Ft. from N. Line

\_\_\_\_\_ Ft. from S. Line

\_\_\_\_\_ Ft. from E. Line

330 Ft. from W. Line

0			

Location \_\_\_\_\_

Rig up \_\_\_\_\_

Drilling and Remarks:

cellar

RECORD

Cased \_\_\_\_\_ in., \_\_\_\_\_ ft.

Sand \_\_\_\_\_

Gas \_\_\_\_\_

Oil \_\_\_\_\_

Total Depth \_\_\_\_\_

PRODUCTION

1st 24 hrs. Nat. \_\_\_\_\_

1st 24 hrs. after shot \_\_\_\_\_

Gas \_\_\_\_\_ Cu. Ft.

Dry Hole \_\_\_\_\_

Abandoned \_\_\_\_\_

Date

AUG 11 1937 19

H. D. Hatfield Scout

Russell KANSAS

KANSAS

Map No. 73 Sec. 30 Twp. 15 R. 13W

Well No. 3-H. Sellens

Coralena Company

Contractor

SECTION PLAT

990 Ft. from N. Line

\_\_\_\_\_ Ft. from S. Line

\_\_\_\_\_ Ft. from E. Line

330 Ft. from W. Line

0			

COMPLETED

Location \_\_\_\_\_

Rig up \_\_\_\_\_

Drilling and Remarks:

2000 and  
Pump 495.22 4 hrs  
498 4 hrs

Potential  
2971 bbls

RECORD

Cased \_\_\_\_\_ in., \_\_\_\_\_ ft.

Sand ~~\_\_\_\_\_~~ 3296

Gas \_\_\_\_\_

Oil \_\_\_\_\_

Total Depth 3296

PRODUCTION

1st 24 hrs. Nat. \_\_\_\_\_

1st 24 hrs. after shot \_\_\_\_\_

Gas \_\_\_\_\_ Cu. Ft.

Dry Hole \_\_\_\_\_

Abandoned \_\_\_\_\_

Date


SEP 22 1937 19

H. D. Hatfield Scout

Sec. **30** Twp. **15** R. **13W**

Well No. **#3 H. Sellens** Farm  
**Coralena** Company

**990** Ft. from N. Line  
 \_\_\_\_\_ Ft. from S. Line  
 \_\_\_\_\_ Ft. from E. Line  
**330** Ft. from W. Line

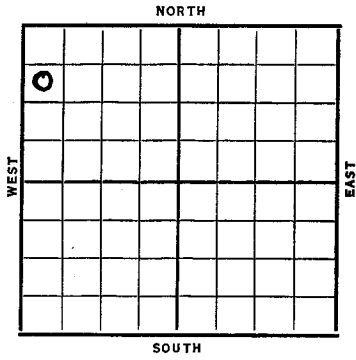

Elev. 1860

Date	REPORT
1937	
8/11	Cellar
8/20	R. R.
8/28	T.D. 495'. Reaming.
9/3	12" @ 493'. Drlg. 2150'.
9/10	Drlg. 3160'.
9/17	Sil. 3295'. 8" @ 3295'. T.D. 3296'. Drlg. plug. No shows Rep.
9/22	Sil. 3295'. 2000 acid. <i>T.D. 3296</i> Pump 495.22 bbls. 4 hrs. 498 bbls. 4 hrs. Potential 2971 bbls.
	<b>COMPLETED</b>

Section **30** Township **15** Range **13-W**

Well No. **#3 H. Sellens**

Company **Coralena**

