

*Russell*

Map No. 73 Sec. 30 Twp. 15 R. 13<sup>w</sup>

Well No. 2-Sellens Heirs "B"

Coralena Company

Contractor

FIRST REPORT

990 Ft. from N. Line

\_\_\_\_\_ Ft. from S. Line

\_\_\_\_\_ Ft. from E. Line

990 Ft. from W. Line

SECTION PLAT

0			

Location \_\_\_\_\_

Rig up \_\_\_\_\_

Drilling and Remarks:

*R. U.*

RECORD

Cased \_\_\_\_\_ in., \_\_\_\_\_ ft.

Sand \_\_\_\_\_

Gas \_\_\_\_\_

Oil \_\_\_\_\_

Total Depth \_\_\_\_\_

PRODUCTION

1st 24 hrs. Nat. \_\_\_\_\_

1st 24 hrs. after shot \_\_\_\_\_

Gas \_\_\_\_\_ Cu. Ft.

Dry Hole \_\_\_\_\_

Abandoned \_\_\_\_\_

Date **JUL 21 1937**

H. D. Hatfield Scout

*Russell* KANSAS

Map No. \_\_\_\_\_ Sec. 30 Twp. 15 R. 13<sup>w</sup>

Well No. 2-Hank Sellens

Coralena Company

Contractor

CORRECTION

990 Ft. from N. Line

\_\_\_\_\_ Ft. from S. Line

\_\_\_\_\_ Ft. from E. Line

990 Ft. from W. Line

SECTION PLAT

0			

Location \_\_\_\_\_

Rig up \_\_\_\_\_

Drilling and Remarks:

*first reported  
Gas #2 -  
Sellens Heirs "B"*

RECORD

Cased \_\_\_\_\_ in., \_\_\_\_\_ ft.

Sand \_\_\_\_\_

Gas \_\_\_\_\_

Oil \_\_\_\_\_

Total Depth \_\_\_\_\_

PRODUCTION

1st 24 hrs. Nat. \_\_\_\_\_

1st 24 hrs. after shot \_\_\_\_\_

Gas \_\_\_\_\_ Cu. Ft.

Dry Hole \_\_\_\_\_

Abandoned \_\_\_\_\_

Date

AUG 4 - 1937 H. D. Hatfield Scout

**KANSAS**

Map No. \_\_\_\_\_ Sec. 30 Twp. 15 R. 13W


Well No. 2-Hank Sellens

Coralena oil Company

Contractor

**COMPLETED**

**SECTION PLAT**

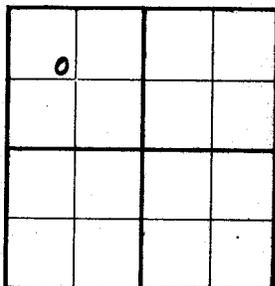

990 Ft. from N. Line

\_\_\_\_\_ Ft. from S. Line

\_\_\_\_\_ Ft. from E. Line

990 Ft. from W. Line

**Russell KANSAS**

Sec. 30 Twp. 15 R. 13W

Well No. #2 Sellens Hairs Farm

Coralena Company


990 Ft. from N. Line

\_\_\_\_\_ Ft. from S. Line

\_\_\_\_\_ Ft. from E. Line

990 Ft. from W. Line

Elev. 1877

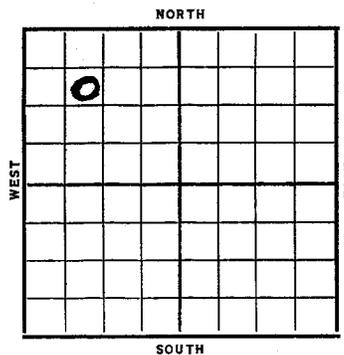

Location \_\_\_\_\_

Rig up \_\_\_\_\_

Drilling and Remarks:

1000 acid

**RECORD**

Cased 8 in. 3318 ft.

Sand 3318

Gas \_\_\_\_\_

Oil \_\_\_\_\_

Total Depth 3320

**PRODUCTION**

1st 24 hrs. Nat. \_\_\_\_\_

1st 24 hrs. after shot. \_\_\_\_\_

Gas \_\_\_\_\_ Cu. Ft.

Dry Hole \_\_\_\_\_

Abandoned \_\_\_\_\_

potential  
2520 bbls

Date  
SEP 8 1937<sub>19</sub>

H. D. Hatfield  
Scout

Date	REPORT
1937	
7/21	R.U.
7/30	"
8/6	"
8/13	S. H.
8/20	15" @ 516'. Drlg. 2020'.
8/28	Drlg. 3050'.
9/3	8" @ 3318'. Sil. 3318'.
	T.D. 3319'. No shows reported.
9/8	8" @ 3318'.
	Silicious 3318'.
	T.D. 3320'.
	1000 acid.
	Potential 2520 bbls.
	<b>COMPLETED</b>

Russell

KANSAS

Section 30 Township 15 Range 13-W

Well Number #2 *Hank Sellens* ~~Sellens Heirs "B"~~

Company Coralena

