

Map No. 73 Sec. 30 Twp. 15 R. 18W

Well No. 2 Trapp

Coralena Oil Company

Contractor

SECTION PLAT

			0

\_\_\_\_\_ Ft. from N. Line

990 Ft. from S. Line

330 Ft. from E. Line

\_\_\_\_\_ Ft. from W. Line

FIRST REPORT

Map No. 73 Sec. 30 Twp. 15 R. 18W

Well No. 2 Trapp

Coralena Company

Contractor

SECTION PLAT

			0

\_\_\_\_\_ Ft. from N. Line

990 Ft. from S. Line

330 Ft. from E. Line

\_\_\_\_\_ Ft. from W. Line

COMPLETED

Location \_\_\_\_\_

RECORD

Cased \_\_\_\_\_ in., \_\_\_\_\_ ft.

Sand \_\_\_\_\_

Gas \_\_\_\_\_

Oil \_\_\_\_\_

Total Depth \_\_\_\_\_

PRODUCTION

1st 24 hrs. Nat. \_\_\_\_\_

1st 24 hrs. after shot \_\_\_\_\_

Gas \_\_\_\_\_ Cu. Ft.

Dry Hole \_\_\_\_\_

Abandoned \_\_\_\_\_

*Burrowing Rig*

Location \_\_\_\_\_

RECORD

Cased \_\_\_\_\_ in., \_\_\_\_\_ ft.

Sand \_\_\_\_\_

Gas \_\_\_\_\_

Oil \_\_\_\_\_

Total Depth 3262

PRODUCTION

1st 24 hrs. Nat. \_\_\_\_\_

1st 24 hrs. after shot \_\_\_\_\_

Gas \_\_\_\_\_ Cu. Ft.

Dry Hole \_\_\_\_\_

Abandoned \_\_\_\_\_

*Sil 8260*

*2000 Acid*

*P 2065*

Date

MAY 13 1936 19

S. J. LEWIS

Scout

Date

MAY 13 1936 19

S. J. LEWIS


Scout

Russell

Map No. **KANSAS** Sec. 30 Twp. 15 R. 13W

Well No. #2 Trapp Farm

Coralena Oil. Company

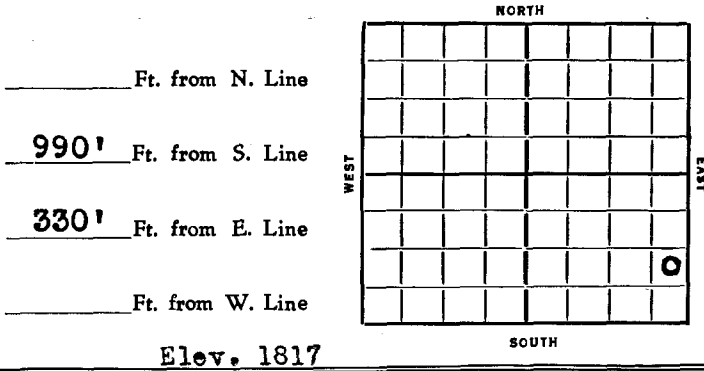

REPORT

Date 1936

5/13 Building rig.

5/21 Drlg. 150'.

5/28 Drlg. 564'.

6/4 Anhydrite 792'. Drlg. 1672'.

6/11 8" @ 2077'. Drlg. 2179'.

6/18 Drlg. 2570'.

6/25 Fishing.

7/2 Drlg. 2625'.

7/9 Drlg. 2880'.

7/16 Oswald 3003'. Show oil 3125-29'.

6" @ 3231'. Drlg. 3250'.

7/22/36-Sil. 3260'.

T.D. 3262'.

2000 gallons of acid.

2065 bbls of oil potential.

**COMPLETED**

Russell

Section 30 Township 15 Range 13-W

Well Number #2-Trapp

Company Coralena Oil

