

Map No. 73 Sec. 30 Twp. 15 R. 13WWell No. 3 Sellen "A"Southern Oil Company

Contractor

SECTION PLAT

990 Ft. from N. Line

Ft. from S. Line

330 Ft. from E. Line

Ft. from W. Line

FIRST REPORT

Location

Rig up

Drilling and Remarks:

Rig

RECORD

Cased _____ in., _____ ft.

Sand _____

Gas _____

Oil _____

Total Depth _____

PRODUCTION

1st 24 hrs. Nat. _____

1st 24 hrs. after shot _____

Gas _____ Cu. Ft.

Dry Hole _____

Abandoned _____

Date

NOV 25 1936 19S. J. LEWIS ScoutMap No. 73 Sec. 30 Twp. 15 R. 13WWell No. 3 Sellen "A"Southern Company

Contractor

SECTION PLAT

990 Ft. from N. Line

Ft. from S. Line

330 Ft. from E. Line

Ft. from W. Line

COMPLETED

Location

Rig up

Drilling and Remarks:

Sil 3266.4000 acidP 2232

RECORD

Cased _____ in., _____ ft.

Sand _____

Gas _____

Oil _____

Total Depth 3270

PRODUCTION

1st 24 hrs. Nat. _____

1st 24 hrs. after shot _____

Gas _____ Cu. Ft.

Dry Hole _____


Abandoned _____

Date

JAN 20 1937 19S. J. LEWIS Scout

Form 252-A-5M-7-36-Palace **KANSAS** Russell
Sec. 30 Twp. 15 R. 13-W
Well No. #3 Sellens "A" Farm
Southern Oil Company

990 Ft. from N. Line
 Ft. from S. Line
330 Ft. from E. Line
 Ft. from W. Line
Elev. 1835

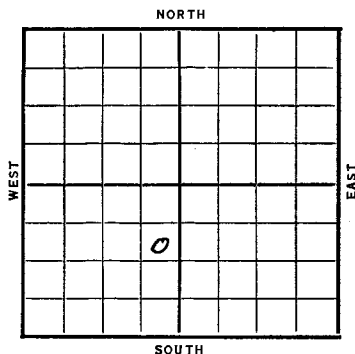

Date	REPORT
1936	
11/25	Rig
12/3	12" @ 250'. Drlg. 1100'.
12/10	Drlg. 2485'.
12/17	Kansas City 3015'. 7" @ 3017'. RUST.
12/24	Drlg. 3190'.
12/29	" "
1937	
1/7	Sil. 3260'. Drlg. 3270'.
1/14	T. D. 3270'. 4000 acid. Pump 1250 bbls. 15 hrs.
1/20	Sil. 3266'. T. D. 3270'. 4000 acid. Pot. 2232.
	COMPLETED

Form 51-5M-10-36 Com'l Russell
KANSAS
Section 30 Township 15 Range 13W
Well Number 3 Sellens "A"
Company Southern Oil

