

Russell

Map No. 23 Sec. 30 Twp. 15 R. 13 W

Well No. 6 - Sellens Heirs "B"

Southern Company

Contractor

FIRST REPORT

SECTION PLAT

Ft. from N. Line

990 Ft. from S. Line

990 Ft. from E. Line

Ft. from W. Line

	0		

Location

Rig up

Drilling and Remarks:

RECORD

Cased in., ft.

Sand

Gas

Oil

Total Depth

PRODUCTION

1st 24 hrs. Nat.

1st 24 hrs. after shot

Gas Cu. Ft.

Dry Hole

Abandoned

Date

JUN 16 1937 19

H. D. Hatfield

Scout

Russell

Map No. Sec. 30 Twp. 15 R. 13 W

Well No. 6 - Sellens Heirs "B"

Southern Company

Contractor

COMPLETED

SECTION PLAT

Ft. from N. Line

990 Ft. from S. Line

990 Ft. from E. Line

Ft. from W. Line

	0		

Location

Rig up

Drilling and Remarks:

2000 Acid

Rump 1424/12

Pot - 2848

7" - 3056 RECORD

Cased 5" LIPER in., 3299 ft.

Sand 511 3300

Gas

Oil

Total Depth 330.5

PRODUCTION

1st 24 hrs. Nat.

1st 24 hrs. after shot

Gas Cu. Ft.

Dry Hole

Abandoned

Date

JUL 28 1937 19

E. D. Hatfield

Scout

Sec. 30 Twp. 15 R. 13-W

Well No. #6 Sellens Heirs "B" Farm

Southern Company


\_\_\_\_\_ Ft. from N. Line

990 Ft. from S. Line

990 Ft. from E. Line

\_\_\_\_\_ Ft. from W. Line

Elev. 1864

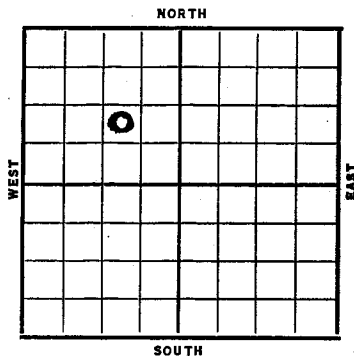

Date	REPORT
<b>1937</b>	
<b>6/16</b>	<b>Location</b>
<b>6/25</b>	<b>R U R</b>
<b>7/2</b>	<b>10" @ 292'. Drlg. 1335'.</b>
<b>7/9</b>	<b>Drlg. 2710'.</b>
<b>7/16</b>	<b>Oswald 3053'. 7" @ 3056'.</b>
	<b>Drlg. 3080'.</b>
<b>7/23</b>	<b>Sil. 3300'.</b>
	<b>5" liner cemented.</b>
<b>7/28</b>	<b>7" @ 3056'.</b>
	<b>5" liner 3299'.</b>
	<b>Sil. 3300'.</b>
	<b>T.D. 3303'.</b>
	<b>2000 acid.</b>
	<b>Pump 1424 bbls. 12 hrs.</b>
	<b>Pot. 2848 bbls.</b>
	<b>COMPLETED</b>

Section 30 Township 15 Range 13-W

Well No. 6 - Sellens Heirs "B"

Company Southern

