

KANSAS

Map No. 73 Sec. 31 Twp. 15 R. 12WWell No. 7 ShafferSouthern Out Company

Contractor

SECTION PLAT

		0	

990 Ft. from N. Line

_____ Ft. from S. Line

_____ Ft. from E. Line

990 Ft. from W. Line

FIRST REPORT

Location _____

RECORD

Cased _____ in., _____ ft.

Sand _____

Gas _____

Oil _____

Total Depth _____

PRODUCTION

1st 24 hrs. Nat. _____

1st 24 hrs. after shot _____

Gas _____ Cu. Ft.

Dry Hole _____

Abandoned _____

Rig up _____
Drilling and Remarks:Rigging up

Date

SEP 9 1936

S. J. LEWIS

Scout

KANSAS

Map No. 73 Sec. 31 Twp. 15 R. 12WWell No. 7 ShafferSouthern Out Company

Contractor

SECTION PLAT

		0	

990 Ft. from N. Line

_____ Ft. from S. Line

_____ Ft. from E. Line

990 Ft. from W. Line

COMPLETED

Location _____

RECORD

Cased _____ in., _____ ft.

Sand _____

Gas _____

Oil _____

Total Depth 8253

PRODUCTION

1st 24 hrs. Nat. _____

1st 24 hrs. after shot _____

Gas _____ Cu. Ft.

Dry Hole _____

Abandoned _____

Rig up _____
Drilling and Remarks:Bit 3247
4000 acid
P 82722

Date

OCT 28 1936

S. J. LEWIS

Scout

KANSAS

Russell

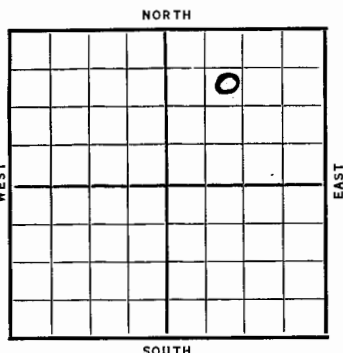
Sec. 31 Twp. 15 R. 13WWell No. #7 Shaffer Farm
Southern Oil Company990' Ft. from N. Line

Ft. from S. Line

Ft. from E. Line

990' Ft. from W. Line

Elev. 1821

~~1946~~

REPORT

9/9 Rigging up.

9/18 10" @ 250'. Waiting on cement.

9/24 Drlg. 1950'.

10/1 Drlg. 2770'.

10/8 Oswald 3005'. 7" @ 3010'. TD.
3023'. Rigging up standard tools.

10/15 Drlg. 3210'.

10/22 Sil. 3247'. T.D. 3253' hoel full
of oil. 4000 gallons of acid.
No test.

10/28/36-Sil. 3247'.
T.D. 3253'.
4000 gallons of acid.
Potential 2722 bbls of oil.

COMPLETED

KANSAS

Form 51-5M-4-36-Palace

Russell

Section 31 Township 15 Range 13-WWell Number #7-ShafferCompany Southern Oil