

KANSAS *Russell*Map No. 73 Sec. 31 Twp. 15 R. 18^WWell No. 6 MichaelisSouthern Oil Company

Contractor

SECTION PLAT

	0		

990 Ft. from N. Line

Ft. from S. Line

990 Ft. from E. Line

Ft. from W. Line

FIRST REPORT

Location ✓

RECORD

Cased _____ in., _____ ft.

Sand _____

Gas _____

Oil _____

Total Depth _____

PRODUCTION

1st 24 hrs. Nat. _____

1st 24 hrs. after shot _____

Gas _____ Cu. Ft.

Dry Hole _____

Abandoned _____

Date

MAR 27 1937

19

S. J. LEWIS

Scout

Russell KANSAS

Map No. _____ Sec. 31 Twp. 15 R. 13^WWell No. 6-MichaelisSouthern Company

Contractor

SECTION PLAT

	0		

COMPLETED990 Ft. from N. Line

Ft. from S. Line

990 Ft. from E. Line

Ft. from W. Line

Location _____

RECORD

Cased _____ in., _____ ft.

Sand Sil 3273

Gas _____

Oil _____

Total Depth 3277¹/₂

PRODUCTION

1st 24 hrs. Nat. _____

1st 24 hrs. after shot _____

Gas _____ Cu. Ft.

Dry Hole _____

Abandoned _____

Date

APR 28 1937

19

W. Hatfield Scout

KANSAS

Russell

O. W. P. B

Sec. 31 Twp. 15 R. 13WWell No. #6 Michaelis FarmSouthern Oil Carter Oil Co. Company

FORM 513 SUNRAY

O. W. P. B.

County Russell Elev. 1850 DF
 Sec. 31 Twp. 15 Rge. 13W
 Company Carter Oil Co.
 Farm Name Michaelis No. 6

TOPS	DEPTH	LOG	DATUM	OWPB
Ank.				Loc. in Sec. <u>SW NE NW</u>
Tr.		<u>2728</u>		
H.		<u>2958</u>		
Tr.		<u>2971</u>		
Dg.				
Bl.				
L.		<u>3026</u>		Geol.
N.C.				Contr.
B.K.C.				
Co.				
C.				
M.				Pool
M.				Trap
K.				
Mr.				
Mo.				
V.				
S.				
S.				
A.	<u>3273</u>	<u>3272</u>		
R.				
PC.				
G.				
TD.				

FIRST REPORT
COMPLETED

Date Comm. Old info - OTD 3277; 5" 3273;
last Arb. prod. 8-21-56 was p 4 bo / 409
bwpd

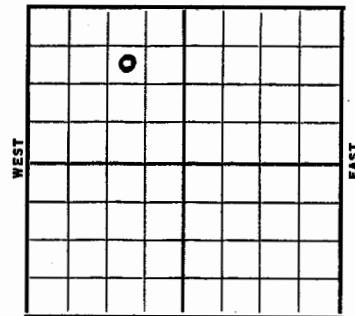
New info - PB 3154; w/rock; 24/3042-46;
no test; 2000 A; s 1d & S 6 bo / 114 bwpd;
PB TD 2952; 16/2894-98; sdn & S 1/2 bo / 35

bw 9 hr. nat.; 500 MCA; rec 1d & s 10 bo
/ 19 bw in 12 hr.; pmp 3 bo / 13 bwpd; 2000

jell A; rec 1d; p 8 bo / 24 bwpd no gas

Complete from Topeka OCT 10 56

NORTH

990 Ft. from N. Line Ft. from S. Line990 Ft. from E. Line Ft. from W. Line

SOUTH

Date	REPORT
<u>1937</u>	
<u>3/17</u>	<u>Location</u>
<u>3/25</u>	<u>10" @ 274'. WOC.</u>
<u>4/2</u>	<u>Drlg. 2700'.</u>
<u>4/8</u>	<u>Oswald and 7" 3033' WOC</u>
<u>4/16</u>	<u>Drlg. 3170'.</u>
<u>4/23</u>	<u>Sil. 3272', set 5" liner.</u> <u>WOC.</u>
<u>4/28</u>	<u>Sil. 3273'.</u> <u>T.D. 3277 1/2'.</u> <u>2000 acid.</u> <u>Pot. 2589.</u>
	COMPLETED

Form 51-5M-12-36 Cont. **O. W. P. B** KANSAS Russell

Section 31 Township 15 Range 13-W

Well Number 6 Michaelis

Company Southern Oil *Carter Oil Co.*

