

Map No. 73 Sec. 31 Twp. 15 R. 13WMap No. 73 Sec. 31 Twp. 15 R. 13WWell No. 1 MichaelisWell No. 1 MichaelisTeaty Oil CompanyTeaty Oil Company

Contractor

Contractor

## SECTION PLAT

|  |   |  |  |
|--|---|--|--|
|  |   |  |  |
|  | 0 |  |  |
|  |   |  |  |
|  |   |  |  |

Ft. from N. Line

990 Ft. from S. Line330 Ft. from E. Line

Ft. from W. Line

FIRST REPORT

Location

## RECORD

Cased in., ft.

Sand

Gas

Oil

Total Depth

## PRODUCTION

1st 24 hrs. Nat.

1st 24 hrs. after shot

Gas Cu. Ft.

Dry Hole

Abandoned

Rig up

Drilling and Remarks:

Rigging up

Date

JUN 10 1936

19

Scout

## SECTION PLAT

|  |   |  |  |
|--|---|--|--|
|  |   |  |  |
|  | 0 |  |  |
|  |   |  |  |
|  |   |  |  |

Ft. from N. Line

990 Ft. from S. Line330 Ft. from E. Line

Ft. from W. Line

COMPLETED

Location

## RECORD

Cased in., ft.

Sand

Gas

Oil

Total Depth 2896

## PRODUCTION

1st 24 hrs. Nat.

1st 24 hrs. after shot

Gas Cu. Ft.

Dry Hole

Abandoned

Rig up

Drilling and Remarks:

Spoke 28811000 aadP. 8 596 Oil4% water

Date

NOV 10 1936

19

S. J. LEWIS

Scout

Russell


Map No. KANSAS Sec. 31 Twp. 15 R. 15WWell No. #1 Michaelis FarmDerby Oil Company

Ft. from N. Line

990' Ft. from S. Line330' Ft. from E. Line

Ft. from W. Line

Elev. 1830

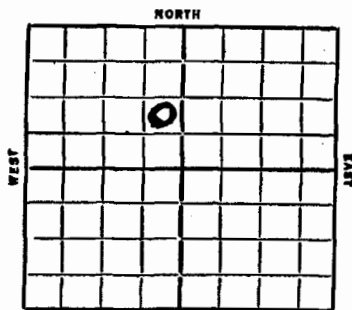

1936

11/10--Topeka 2881

T. D. 2896

1000 Acid

Pot. 596 Oil 4% Water

COMPLETED

| Date                              | REPORT                                                |
|-----------------------------------|-------------------------------------------------------|
| 1936                              |                                                       |
| 6/10                              | Rigging up.                                           |
| 6/18                              | --                                                    |
| 6/25                              | Spud.                                                 |
| 7/2                               | Shut down.                                            |
| 7/9                               | 15" @ 406'. Waiting on cement.                        |
| 7/16                              | Drlg. 1225'.                                          |
| 7/23                              | Drlg. 1805'.                                          |
| 7/30                              | Drlg. 2205'.                                          |
| 8/6                               | Topeka 2706'. Drlg. 2787'.                            |
| 8/13                              | 8" @ 2826'. TD 2860'. Under ream 8".                  |
| 8/20                              | Topeka 2881-96'. Swab 12½ bbls per hour for 15 hours. |
| 8/27                              | Shut down.                                            |
| 9/3                               | --                                                    |
| 9/10                              | Pump 563 bbls of oil in 7 hours.                      |
| 9/18                              | 578 bbls of oil. 2½% water. in 15 hours.              |
| 9/24                              | Shut down.                                            |
| 10/1--10/8--10/15--10/22--10/29-- |                                                       |
| 11/6--                            |                                                       |
|                                   | OVER                                                  |

KANSAS

Russell

Form 51-5M-4-56-Palace

Section 31 Township 15 Range 11-W

Well Number 1-Michaelis

Company Derby Oil

