

KANSAS

Map No. 73 Sec. 21 Twp. 15 R. 13WWell No. 4 MichaelisShell Company

Contractor

SECTION PLAT

_____ Ft. from N. Line

990 Ft. from S. Line

_____ Ft. from E. Line

987 Ft. from W. Line

FIRST REPORT

Location _____

Rig up _____

Drilling and Remarks:

12" @ 56'

RECORD

Cased _____ in., _____ ft.

Sand _____

Gas _____

Oil _____

Total Depth _____

PRODUCTION

1st 24 hrs. Nat. _____

1st 24 hrs. after shot _____

Gas _____ Cu. Ft.

Dry Hole _____

Abandoned _____

Date

OCT 21 1936

19

S. J. LEWIS

Scout

KANSAS

Map No. 73 Sec. 21 Twp. 15 R. 13WWell No. 4 MichaelisShell Company

Contractor

SECTION PLAT

_____ Ft. from N. Line

990 Ft. from S. Line

_____ Ft. from E. Line

987 Ft. from W. Line

COMPLETED

Location _____

Rig up _____

Drilling and Remarks:

8.732652000 acidP 82411

RECORD

Cased _____ in., _____ ft.

Sand _____

Gas _____

Oil _____

Total Depth 3223

PRODUCTION

1st 24 hrs. Nat. _____

1st 24 hrs. after shot _____

Gas _____ Cu. Ft.

Dry Hole _____

Abandoned _____

Date

NOV 25 1936

19

S. J. LEWIS Scout

CO. Russell ELEV 1840
 SEC. 31 TWP. 15 RGE. 13W
 COMPANY Shell Oil Co. NO. 4

FIRST REPORT

DEC 18 1937

COMPLETE

FARM J. J. Michaelis (O.W.P.B.)LOC. NE SW NE (app) 330' fsl x 987' fsl NE 1/4Lans 3025Arb 3625OTD 3273

GEOL. _____

CONTR. _____

POOL Trapp

SPUD _____

OLD INFO: spud 10/11/36,

Tops. 7" @ 3262, was

Arb Prod. Complete
11/28/36.NEW INFO: PB 3195,
perf 12/3115-18, 2000A

P 11 BO & 25 BW 24 hrs from Lans 3115-18

COMPLETE

CO.

SEC.

NO.

SEC.

TWP.

RGE.

Sec. 31 Twp. 15 R. 13W

Well No. #4 Michaelis Farm

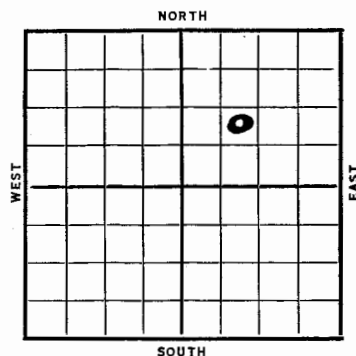
Shell Company

_Ft. from N. Line

990' Ft. from S. Line

_Ft. from E. Line

987' Ft. from W. Line

[illegible]

Section 31 Township 15 Range 13-W

Well Number #4 Michaelis

Company Shell

