

Russell KANSAS

Map No. _____ Sec. 31 Twp. 15 R. 13^W

Well No. 16-Hoffman

Phillips Company

Contractor

FIRST REPORT

SECTION PLAT

			0

_____ Ft. from N. Line

330 Ft. from S. Line

330 Ft. from E. Line

_____ Ft. from W. Line

Location _____

RECORD

Cased _____ in., _____ ft.

Sand _____

Gas _____

Oil _____

Total Depth _____

PRODUCTION

1st 24 hrs. Nat. _____

1st 24 hrs. after shot _____

Gas _____ Cu. Ft.

Dry Hole _____

Abandoned _____

Rig up _____

Drilling and Remarks:

R. O. G.

Date

JUL 7 1937 19 H. D. Hatfield Scout

Russell KANSAS

Map No. _____ Sec. 31 Twp. 15 R. 13^W

Well No. 16-Hoffman

Phillips Company

Contractor

COMPLETED

SE/C

SECTION PLAT

			0

_____ Ft. from N. Line

330 Ft. from S. Line

330 Ft. from E. Line

_____ Ft. from W. Line

Location _____

RECORD

Cased 7 in., 3342¹/₂ ft.

Sand 511 3342¹/₂

Gas _____

Oil _____

Total Depth 3361

PRODUCTION

1st 24 hrs. Nat. _____

1st 24 hrs. after shot _____

Gas _____ Cu. Ft.

Dry Hole _____

Abandoned _____

Rig up _____

Drilling and Remarks:

4000 acid

P. - 538/4 + 540/4

Pat - 32321

Date

SEP 29 1937 19 H. D. Hatfield Scout

Sec. 31 Twp. 15 R. 13-W

Well No. #16 Hoffman Farm


Phillips Company

 Ft. from N. Line

330' Ft. from S. Line

330' Ft. from E. Line

 Ft. from W. Line

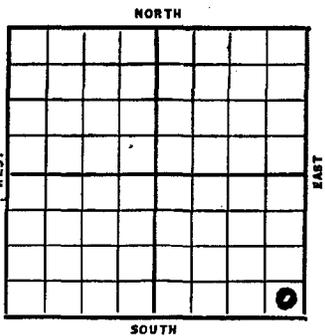

Elev. 1908

Date	REPORT
1937	
7/7	R.O.G.
7/16	R. R.
7/23	"
7/30	"
8/6	"
8/13	"
8/20	10" @ 600'. WOC.
8/28	Drlg. 2919'.
9/3	Sil. & 7" @ 3342½'. WOC.
	No shows reported.
9/10	RUST.
9/17	T.D. 3361'. Swabbing 70 B.O.P. hour. Will acidize.
9/24	4000 acid. On potential.
	OVER

1937
9/29

7" @ 3342½'.
 Sil. 3342½'.
 T.D. 3361'.
 4000 acid.
 P. 538 bbls. 4 hrs & 540 bbls.
 4 hrs.
 Pot. 3232 bbls.

COMPLETED

Russell KANSAS

Section **31** Township **15** Range **13W**

Well Number **#16 Hoffman**

Company **Phillips**

