

Russell KANSAS
 Map No. 73 Sec. 31 Twp. 15 R. 13^W
 Well No. 11-Hoffman
Phillips Pet Company
 Contractor

FIRST REPORT

SECTION PLAT

			0

_____ Ft. from N. Line
990 Ft. from S. Line
990 Ft. from E. Line
 _____ Ft. from W. Line

Location _____

RECORD

Cased _____ in., _____ ft.

Rig up _____

Sand _____

Drilling and Remarks:

Gas _____

Oil _____

Total Depth _____

PRODUCTION

1st 24 hrs. Nat. _____

1st 24 hrs. after shot _____

Gas _____ Cu. Ft.

Dry Hole _____

Abandoned _____

Date

MAY 12 1937 19

H. D. Hatfield

Scout

Russell KANSAS
 Map No. _____ Sec. 31 Twp. 15 R. 13^W
 Well No. 11-Hoffman
Phillips Company
 Contractor

COMPLETED

SECTION PLAT

			0

_____ Ft. from N. Line
990 Ft. from S. Line
990 Ft. from E. Line
 _____ Ft. from W. Line

Location _____

RECORD

Cased 7 in., 3335 ft.

Rig up _____

Sand 511 3335

Drilling and Remarks:

Gas _____

Oil _____

Total Depth 3342

PRODUCTION

1st 24 hrs. Nat. _____

1st 24 hrs. after shot _____

Gas _____ Cu. Ft.

Dry Hole _____

Abandoned _____

Date

JUL 14 1937 19

H. D. Hatfield

Scout

KANSAS

Russell


Sec. 31 Twp. 15 R. 13-WWell No. #11 Hoffman FarmPhillips Pet. Company

Ft. from N. Line

990 Ft. from S. Line990 Ft. from E. Line

Ft. from W. Line

Elev. 1907

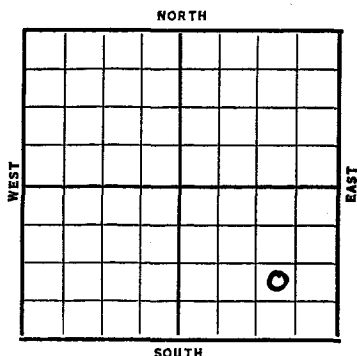

Date	REPORT
1937	
5/12	B.R.R.
5/21	Surface Hole.
5/28	10" @ 604'. Drlg. 2155'.
6/4	Coring 3115'.
6/11	Sil. & 7" @ 3336'. WOO.
6/19	T.D. 3342'. Swab 428 bbls.
	15 hrs.
6/25	" "
7/2	" "
7/9	" "
7/14	7" @ 3335'.
	Sil. 3335'.
	T.D. 3342'.
	828 bbls. 12 hrs.
	Pot. 1656 bbls.
	COMPLETED

Russell

KANSAS

Section 31 Township 15 Range 13-WWell Number 11 - HoffmanCompany Phillips Pet.