

Map No. 73 Sec. 81 Twp. 15 R. 13W

Map No. _____ Sec. 31 Twp. 15 R. 13W

Well No. 7 Hoffman
Phillips Company
Contractor

Well No. 7 - Hoffman
Phillips Company
Contractor

SECTION PLAT

990 Ft. from N. Line
_____ Ft. from S. Line
330 Ft. from E. Line
_____ Ft. from W. Line

			0

COMPLETED

SECTION PLAT

990 Ft. from N. Line
330 Ft. from S. Line
330 Ft. from E. Line
_____ Ft. from W. Line

			0

FIRST REPORT

Location ✓
Rig up _____
Drilling and Remarks: _____

RECORD

Cased _____ in., _____ ft.
Sand _____
Gas _____
Oil _____
Total Depth _____

PRODUCTION

1st 24 hrs. Nat. _____
1st 24 hrs. after shot _____
Gas _____ Cu. Ft.
Dry Hole _____
Abandoned _____

Date MAR 10 1937 19 S. J. LEWIS Scout

Location _____
Rig up _____
Drilling and Remarks: 4000 Acid
POT - 2896

RECORD

Cased _____ in., _____ ft.
Sand 511 3385
Gas _____
Oil _____
Total Depth 3343


PRODUCTION

1st 24 hrs. Nat. _____
1st 24 hrs. after shot _____
Gas _____ Cu. Ft.
Dry Hole _____
Abandoned _____

Date APR 28 1937 19 H. Hatfield Scout

Form 252-A-5M-7-36-Palace **KANSAS** Russell
 Sec. 31 Twp. 15 R. 13-W
 Well No. #7 Hoffman Farm
Phillips Company

990 Ft. from N. Line
 _____ Ft. from S. Line
330 Ft. from E. Line
 _____ Ft. from W. Line
 Elev. 1901

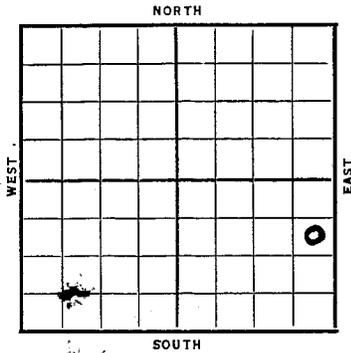

Date	REPORT
3/10	Location
3/18	Rig
3/25	Surface hole.
4/2	10" @ 598'. Drlg. 1785'
4/8	KCL 3093' Coring 3125'
4/16	Sil 3335' set 7" T.D. 3337'
4/23	T.D. 3343'. 4000 acid. No test.
4/28	Sil. 3335'. T.D. 3343'. 4000 acid. Pot. 2896.
COMPLETED	

Form 51-5M-4-36-Palace **KANSAS** Russell
 Section 31 Township 15 Range 13-W
 Well Number 7 Hoffman
 Company Phillips

