

Trapp Pool

Map No. \_\_\_\_\_ Sec. 31 Twp. 15 R. 13W

Well No. 15 Kaufman

Gulf Company

FIRST REPORT Contractor

C NW SW

SECTION PLAT

660 Ft. from N. Line

\_\_\_\_\_ Ft. from S. Line

\_\_\_\_\_ Ft. from E. Line

660 Ft. from W. Line


Russell County

Location \_\_\_\_\_

Rig up \_\_\_\_\_

Drilling and Remarks:

13" @ 522

anhy 770

drlg. 925

SWD

RECORD

Cased \_\_\_\_\_ in., \_\_\_\_\_ ft.

Sand \_\_\_\_\_

Gas \_\_\_\_\_

Oil \_\_\_\_\_

Total Depth \_\_\_\_\_

PRODUCTION

1st 24 hrs. Nat. \_\_\_\_\_

1st 24 hrs. after shot \_\_\_\_\_

Gas \_\_\_\_\_ Cu. Ft.

Dry Hole \_\_\_\_\_

Abandoned \_\_\_\_\_

Date

NOV 5 1947 19

S. J. LEWIS Scout

Trapp Pool

Map No. 73 Sec. 31 Twp. 15 R. 13W

Well No. 16 Kaufman

Gulf Company

CORRECTION Contractor

C NW SW

SECTION PLAT

815 Ft. from N. Line

\_\_\_\_\_ Ft. from S. Line

\_\_\_\_\_ Ft. from E. Line

516 Ft. from W. Line


Russell County

Location \_\_\_\_\_

Rig up \_\_\_\_\_

Drilling and Remarks:

Reported as

#15 Kaufman

660' N. line

660' W. line

RECORD

Cased \_\_\_\_\_ in., \_\_\_\_\_ ft.

Sand \_\_\_\_\_

Gas \_\_\_\_\_

Oil \_\_\_\_\_

Total Depth \_\_\_\_\_

PRODUCTION

1st 24 hrs. Nat. \_\_\_\_\_

1st 24 hrs. after shot \_\_\_\_\_

Gas \_\_\_\_\_ Cu. Ft.

Dry Hole \_\_\_\_\_

Abandoned \_\_\_\_\_

Date

NOV 12 1947 19

S. J. LEWIS Scout

Trapp Pool

Map No. 73 Sec. 31 Twp. 15 R. 13W


Well No. 16 Kaufman

Gulf Company

ABANDONED Contractor

C NW SW

SECTION PLAT

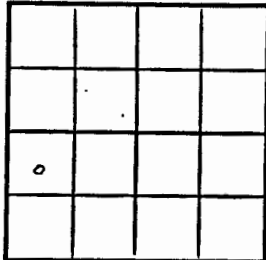

815 Ft. from N. Line

\_\_\_\_\_ Ft. from S. Line

\_\_\_\_\_ Ft. from E. Line

561 Ft. from W. Line

Russell County

Location \_\_\_\_\_

Rig up \_\_\_\_\_

Drilling and Remarks:

*Weathered Granite*  
*8528.*  
*2" @ 3260*  
*SWG*

RECORD

Cased \_\_\_\_\_ in., \_\_\_\_\_ ft.

Sand \_\_\_\_\_

Gas \_\_\_\_\_

Oil \_\_\_\_\_

Total Depth 3532

PRODUCTION

1st 24 hrs. Nat. \_\_\_\_\_

1st 24 hrs. after shot \_\_\_\_\_

Gas \_\_\_\_\_ Cu. Ft.

Dry Hole \_\_\_\_\_

Abandoned \_\_\_\_\_

Date

DEC 30 1947 19

S. J. LEW Scout

KANSAS

Russell

Sec. 31 Twp. 15 R. 13W

Well No. 16 Kaufman Farm \_\_\_\_\_

Gulf Company

815' Trapp Pool


660 Ft. from N. Line

\_\_\_\_\_ Ft. from S. Line

\_\_\_\_\_ Ft. from E. Line

516'  
660 Ft. from W. Line

SW NW SW

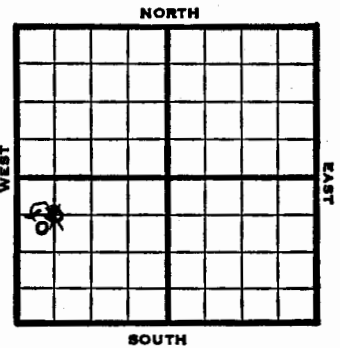

REPORT

1947

11/5

13" @ 522  
anhy 770  
Drlg. 925  
SWD

11/12

2932'

11/19

Arbuckle 3258'  
TD 3273'  
5" @ 3273'

11/25

TD 3316'  
8" @ 3273'

12/3

Drlg. 3351'

12/10

Drlg. 3480'

12/30

Weathered Granite 3528'  
7" @ 3260' SWG  
TD 3532'

ABANDONED

Section 31 Township 15 Range 13W

Well No. #16 15 Kaufman HOFFMAN

Company Gulf

Trapp

