


KANSAS Pool Name Trapp
 Map No. 73 Sec. 31 Twp. 15 R. 13W
 Well No. 15 SWD (Hoffman) twin #14
 Gulf Company
FIRST REPORT Contractor

SE NW SW

SECTION PLAT

1090 Ft. from N. Line
 _____ Ft. from S. Line
 _____ Ft. from E. Line
1060 Ft. from W. Line

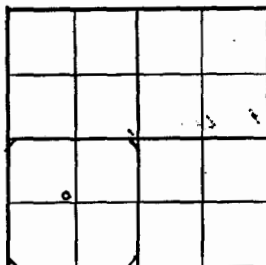

Russell

Location X

Rig up _____

Drilling and Remarks:

RECORD

Cased _____ in., _____ ft.
 Sand _____
 Gas _____
 Oil _____
 Total Depth _____

PRODUCTION

1st 24 hrs. Nat. _____
 1st 24 hrs. after shot _____
 Gas _____ Cu. Ft.
 Dry Hole _____
 Abandoned _____

Date


JUL 3 1945 19 S. J. LEWIS Scout

KANSAS Pool Name Trapp
 Map No. 73 Sec. 31 Twp. 15 R. 13W
 Well No. 15 SWD (Hoffman)
 Gulf Company
ABANDONED Contractor

SE NW SW

SECTION PLAT

1090 Ft. from N. Line
 _____ Ft. from S. Line
 _____ Ft. from E. Line
1060 Ft. from W. Line

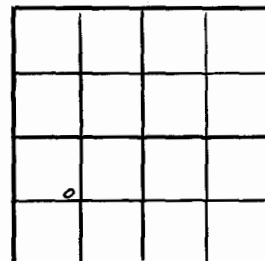

Russell County

Location _____

Rig up _____

Drilling and Remarks:

Granite 554
5 to 3304
SWD!

RECORD

Cased _____ in., _____ ft.
 Sand _____
 Gas _____
 Oil _____
 Total Depth 3524

PRODUCTION

1st 24 hrs. Nat. _____
 1st 24 hrs. after shot _____
 Gas _____ Cu. Ft.
 Dry Hole _____
 Abandoned _____

Date

AUG 29 1945 19 S. J. LEWIS Scout

KANSAS Russell County

Sec. 31 Twp. 15 R. 13W

Well No. #15 SWD (Hoffman) Twin #14 Farm

Gulf Company


Trapp

1090 Ft. from N. Line

Ft. from S. Line

Ft. from E. Line

1060 Ft. from W. Line

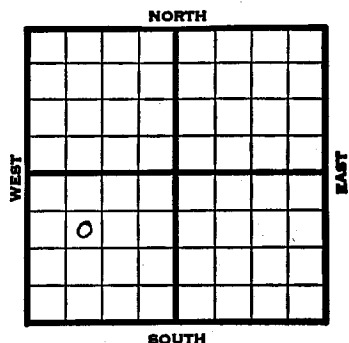

SE NW SW Elev. 1833

REPORT

1945

7/3 Location
7/11 10" @ 615' WOC
7/19 Arb. 3257
Drlg. 3374
7/26 7" @ 3310
TD 3531
PB 3273
8/1 Granite 3574
8/8 5" @ 3304
8/15 " "
8/22 " "
8/29 Granite 3574
5" @ 3304
TD 3574' SWD

ABANDONED

KANSAS

Russell

FORM 51 5M PETROL

Section 31 Township 15 Range 13W

Well No. 15 SWD (Hoffman) twin #14

Company Gulf

