

Russell KANSAS

Map No. 73 Sec. 31 Twp. 15 R. 13^WWell No. 7-Hoffman
Gulf Company
Contractor

FIRST REPORT

SECTION PLAT

1060 Ft. from N. Line

Ft. from S. Line

990 Ft. from E. Line

Ft. from W. Line

	0		

Location

Rig up

Drilling and Remarks:

Cellar

RECORD

Cased in. ft.

Sand

Gas

Oil

Total Depth

PRODUCTION

1st 24 hrs. Nat.

1st 24 hrs. after shot

Gas Cu. Ft.

Dry Hole

Abandoned

Date

JUN 9 1937 19 H. D. Hatfield Scout

Russell

Map No. 73 Sec. 31 Twp. 15 R. 13^WWell No. 7-Hoffman
Gulf Company
Contractor

COMPLETED

SECTION PLAT

1060 Ft. from N. Line

Ft. from S. Line

990 Ft. from E. Line

Ft. from W. Line

	0		

Location

Rig up

Drilling and Remarks:

3000 Acid

Pump 922 1/2 / 12 1/2

Pot-1845

RECORD

Cased 6 in., 3250 ft.

Sand 511 3250

Gas

Oil

Total Depth 3261

PRODUCTION

1st 24 hrs. Nat.

1st 24 hrs. after shot

Gas Cu. Ft.

Dry Hole

Abandoned

Date

JUL 21 1937 19 H. D. Hatfield Scout


Sec. 31 Twp. 15 R. 15

Well No. #7 Hoffman Farm

Gulf

Company

NORTH

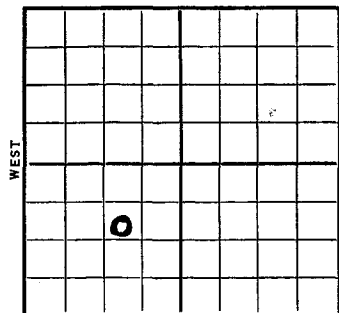

SOUTH

WEST

EAST

1060 Ft. from N. Line

_Ft. from S. Line

990 Ft. from E. Line

Ft. from W. Line

Elev. 1834


Date	REPORT
1937	
6/9	Cellar
6/19	R. R.
6/25	S. H.
7/2	10" @ 582'. Drlg. 1546'.
7/9	Drlg. 2875'.
7/16	Sil. & 7" @ 3250'.
	T.D. 3261'. 3000' oil 3 hrs.
	Swab 145 bbls. 4 hrs.
7/21	Sil 3250'
	6" @ 3250'
	TD 3261'
	3000 acid
	Pump 922½/12 hrs
	Pot 1845
	COMPLETED

Section 31 Township 15 Range 13-W

Well No. 7 - Hoffman

Company Gulf

NORTH

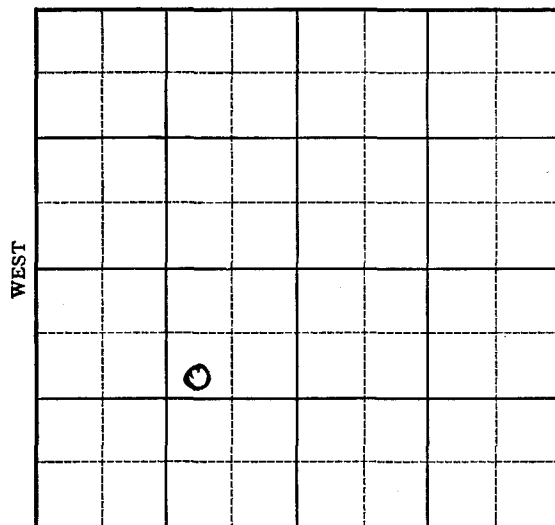

SOUTH

WEST

EAST