

Russell KANSAS

Map No. 73 Sec. 31 Twp. 15 R. 13^WWell No. 6-Hoffman

Company

Contractor

FIRST REPORT

SECTION PLAT

0			

330 Ft. from N. Line

_____ Ft. from S. Line

_____ Ft. from E. Line

330 Ft. from W. Line

Location _____

RECORD

Cased _____ in., _____ ft.

Sand _____

Gas _____

Oil _____

Total Depth _____

PRODUCTION

1st 24 hrs. Nat. _____

1st 24 hrs. after shot _____

Gas _____ Cu. Ft.

Dry Hole _____

Abandoned _____

Date

JUN 9 1937 19 H. D. Hatfield Scout

Russell KANSAS

Map No. _____ Sec. 31 Twp. 15 R. 13^WWell No. 6-Hoffman

Company

Contractor

COMPLETED

SECTION PLAT

0			

330 Ft. from N. Line

_____ Ft. from S. Line

_____ Ft. from E. Line

330 Ft. from W. Line

Location _____

RECORD

Cased 6 in., 3265 ft.Sand 511 3266

Gas _____

Oil _____

Total Depth 3277

PRODUCTION

1st 24 hrs. Nat. _____

1st 24 hrs. after shot _____

Gas _____ Cu. Ft.

Dry Hole _____

Abandoned _____

Date

JUL 14 1937 19 H. D. Hatfield Scout


Sec. 31 Twp. 15 R. 13-WWell No. #6 Hoffman FarmGulf Company330 Ft. from N. Line

Ft. from S. Line

Ft. from E. Line

330 Ft. from W. Line

Elev. 1850

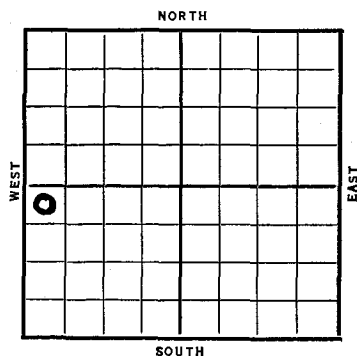

Date REPORT

1937

6/9 Rotary Material

6/19 R. R.

6/25 10" @ 583'. Drlg. 975'.

7/2 Drlg. 2650'.

7/9 6" @ 3265'. Sil. 3266'.

T.D. 3271'.

7/14 6" @ 3265'.

Sil. 3266'.

T.D. 3277'.

1000 acid.

858/12 hrs.

Pot. 1716 bbls.

COMPLETED

Section 31 Township 15 Range 13-WWell No. 6 - HoffmanCompany Gulf