

Form 26-1M Bks.-2-29 **KANSAS**

Map No. 73 Sec. 32 Twp. 15 R. 13W

Well No. 7 Boomhower

Coralina Company

Contractor

SECTION PLAT

	0		

990 Ft. from N. Line

_____ Ft. from S. Line

990 Ft. from E. Line

_____ Ft. from W. Line

FIRST REPORT

Location ☒

Rig up _____

Drilling and Remarks:

RECORD

Cased _____ in., _____ ft.

Sand _____

Gas _____

Oil _____

Total Depth _____

PRODUCTION

1st 24 hrs. Nat. _____

1st 24 hrs. after shot _____

Gas _____ Cu. Ft.

Dry Hole _____

Abandoned _____

Date

FEB 3 1937

19

S. J. LEWIS Scout

Form 26-1M Bks.-2-29

KANSAS Russell

Map No. 73 Sec. 32 Twp. 15 R. 13W

Well No. 7 Boomhower

Coralina Company

Contractor

SECTION PLAT

	0		

990 Ft. from N. Line

_____ Ft. from S. Line

990 Ft. from E. Line

_____ Ft. from W. Line

COMPLETED

Location _____

Rig up _____

Drilling and Remarks:

Oil 3279

Potential

2546

natural

RECORD

Cased _____ in., _____ ft.

Sand _____

Gas _____

Oil _____

Total Depth 3281

PRODUCTION

1st 24 hrs. Nat. _____

1st 24 hrs. after shot _____

Gas _____ Cu. Ft.

Dry Hole _____

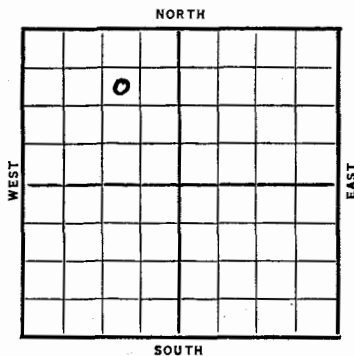
Abandoned _____

Date

MAR 17 1937

19

S. J. LEWIS Scout

Sec. 32 Twp. 15 R. 13-WWell No. #7 Boomhower FarmCoralena Company990 Ft. from N. Line Ft. from S. Line990 Ft. from E. Line Ft. from W. LineElw. 1867Date 1937 REPORT2/3 Location2/11 Rig2/19 12" @ 585 WOC2/26 Drlg. 2430'.3/4 8" @ 3290 WOC.3/11 " " "3/17 Sil. 3279'.

T. D. 3281'.

Potential 2546 natural.

COMPLETEDSection 32 Township 15 Range 13-WWell Number 7 BoomhowerCompany Coralena