

KANSAS

Map No. 72 Sec. 32 Twp. 15 R. 13W

Well No. 3 Bormhouse

Ocala Company

Contractor

SECTION PLAT

0			

990 Ft. from N. Line

_____ Ft. from S. Line

_____ Ft. from E. Line

330 Ft. from W. Line

FIRST REPORT

Location _____

Rig up _____

Drilling and Remarks:

Pond

RECORD

Cased _____ in., _____ ft.

Sand _____

Gas _____

Oil _____

Total Depth _____

PRODUCTION

1st 24 hrs. Nat. _____

1st 24 hrs. after shot _____

Gas _____ Cu. Ft.

Dry Hole _____

Abandoned _____

Date

JUN 3 1936 19 S. J. LEWIS Scout

KANSAS

Map No. 73 Sec. 32 Twp. 15 R. 13W

Well No. 3 Bormhouse

Ocala Company

Contractor

SECTION PLAT

0			

990 Ft. from N. Line

_____ Ft. from S. Line

_____ Ft. from E. Line

330 Ft. from W. Line

ABANDONED

Location _____

Rig up _____

Drilling and Remarks:

Sil 3271

D&H

RECORD

Cased _____ in., _____ ft.

Sand _____

Gas _____

Oil _____

Total Depth 3278

PRODUCTION

1st 24 hrs. Nat. _____

1st 24 hrs. after shot _____

Gas _____ Cu. Ft.

Dry Hole _____

Abandoned _____

Date

OCT 21 1936 19 S. J. LEWIS Scout

Russell

Map No. **KANSAS** Sec. **32** Twp. **15** R. **13W**

Well No. **#3 Boomhower** Farm

Coralena Company


990' Ft. from N. Line

Ft. from S. Line

Ft. from E. Line

330' Ft. from W. Line

Elev. 1836

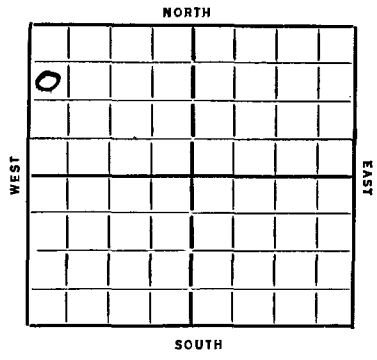

Date	REPORT
1936	
6/3	Pond.
6/11	Machine.
6/18	Rigging up.
6/25	Spud.
7/2	12" @ 457'. Drlg.
7/9	4 1/2" @ 807'. Drlg. 920'.
7/16	Drlg. 1793'.
7/23	Drlg. 2252'.
7/30	Drlg. 2730'.
8/6	2868'. Under ream 8".
8/13	--
8/20	8" @ 2725'. 2868' fishing.
8/27	Oswald 3020'. to 3024'. fishing.
9/3	Siliceous 3263' ^{3271'} . Show of oil.
9/10	3271' Siliceous. CORRECTED.
	T.D. 3278'. 4000 gallons of a cid testing.
9/18	Reacidizing.
9/24	No test.
10/1	--- 10/8--10/15--
10/21/36	Sil. 3271'. TD 3278'. D&A.

ABANDONED

Russell

Section **32** Township **15** Range **13W**

Well Number **#3 Boomhower**

Company **Coralena**

