

Form 26—200 Bks.—1-40—Palace Russell
Map No. _____ Sec. 32 Twp. 15 R. 13W
Well No. 16 Neidens
Skelly Oil _____ Company

Contractor

FIRST REPORT

C S L N $\frac{1}{2}$ SE

992 Ft. from N. Line

_____ Ft. from S. Line

1320 Ft. from E. Line

_____ Ft. from W. Line

TRAPP POOL

SECTION PLAT

Location _____

Rig up _____

Drilling and Remarks:

8" - 314
WOC

RECORD

Cased _____ in., _____ ft.

Sand _____

Gas _____

Oil _____

Total Depth _____

PRODUCTION

1st 24 hrs. Nat. _____

1st 24 hrs. after shot _____

Gas _____ Cu. Ft.

Dry Hole _____

Abandoned _____

Date

JUL 17 1940

19

S. J. LEWIS Scout

Form 26—200 Bks.—1-40—Palace Russell
Map No. 73 Sec. 32 Twp. 15 R. 13W
Well No. 16 Neidens
Skelly Oil _____ Company

Contractor

COMPLETED

C S L N $\frac{1}{2}$ SE

992 Ft. from N. Line

_____ Ft. from S. Line

1320 Ft. from E. Line

_____ Ft. from W. Line

TRAPP POOL

SECTION PLAT

Location _____

Rig up _____

Drilling and Remarks:

at 8326

4" @ 8330

2500 acd

Depth reported

2380

RECORD

Cased _____ in., _____ ft.

Sand _____

Gas _____

Oil _____

Total Depth 3336

PRODUCTION

1st 24 hrs. Nat. _____

1st 24 hrs. after shot _____

Gas _____ Cu. Ft.

Dry Hole _____

Abandoned _____

Date

AUG 7 1940

19

S. J. LEWIS Scout

KANSAS

Russell

FORM 252-A 5M 2-40

Sec. 32 Twp. 15 R. 13-WWell No. #16 Neidens FarmSkelly Oil Company


(Trapp)

992 Ft. from N. Line

Ft. from S. Line

1320 Ft. from E. Line

Ft. from W. Line

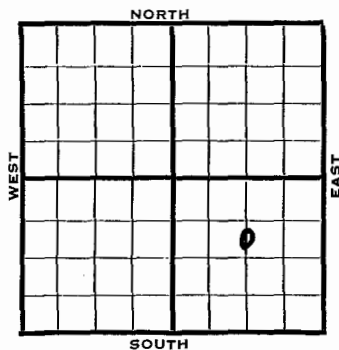

1940	REPORT
7/17	8" - 314' WOC.
7/25	Drlg. 2865'
8/2	Lansing 3068' Arb. 3326-36' TD 1500 acid. Pump 96 bbls. in 10 hours. No water.
8/7	Arb. 3326' 4" - 3330' T.D. 3336' 2500 acid. Depthograph potential 2380 bbls.

COMPLETED

KANSAS

Russell

Form 51-5M-7-39-Palace

Section 32 Township 15 Range 13WWell No. #16 NeidensCompany Skelly Oil