

Map No. 73 Sec. 32 Twp. 15 R. 13W


Well No. 15 Neidens

Skelly Company Contractor

FIRST REPORT

C S L N 1/2 SE

SECTION PLAT

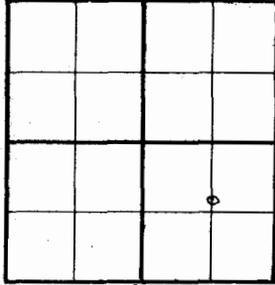

992 Ft. from N. Line

Ft. from S. Line

1320 Ft. from E. Line

Ft. from W. Line

TRAPP POOL

Location

Rig up

Drilling and Remarks: ROG

RECORD

Cased in. ft. Sand Gas Oil Total Depth

PRODUCTION

1st 24 hrs. Nat. 1st 24 hrs. after shot Gas Cu. Ft. Dry Hole Abandoned

Date

JUN 12 1940 19

S. J. LEWIS Scout

Map No. 73 Sec. 32 Twp. 15 R. 13W

Well No. 15 Neidens

Skelly Oil Company Contractor

CORRECTION

SECTION PLAT

C N L SE


330 Ft. from N. Line

Ft. from S. Line

1320 Ft. from E. Line

Ft. from W. Line

TRAPP POOL

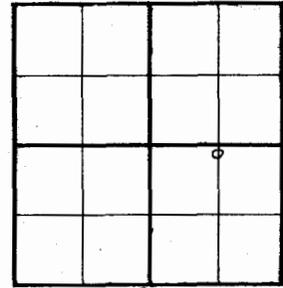

Location

Rig up

Drilling and Remarks: Changed location

RECORD

Cased in. ft. Sand Gas Oil Total Depth

PRODUCTION

1st 24 hrs. Nat. 1st 24 hrs. after shot Gas Cu. Ft. Dry Hole Abandoned

Date

JUN 13 1940 19

S. J. LEWIS Scout

Map No. 73 Sec. 32 Twp. 15 R. 13W

Well No. 15 Neidens

Skelly Oil Company

Contractor

COMPLETED

C N L SE

330 Ft. from N. Line


_____ Ft. from S. Line

1320 Ft. from E. Line

_____ Ft. from W. Line

TRAPP POOL

SECTION PLAT

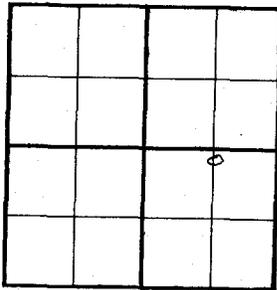

Location _____

Rig up _____

Drilling and Remarks:

*Cor 8 3334
4" @ 3335*

5500 acid

Echometer P.D.

934

RECORD

Cased _____ in., _____ ft.

Sand _____

Gas _____

Oil _____

Total Depth 3342

PRODUCTION

1st 24 hrs. Nat. _____

1st 24 hrs. after shot _____

Gas _____ Cu. Ft.

Dry Hole _____

Abandoned _____

Date

JUL 10 1940 19

S. J. LEWIS Scout

Sec. 32 Twp. 15 R. 13-W

Well No. #15 Neidens Farm

Skelly Company

(Trapp)


~~992~~ 330 Ft. from N. Line

_____ Ft. from S. Line

1320 Ft. from E. Line

_____ Ft. from W. Line

Elev. 1890

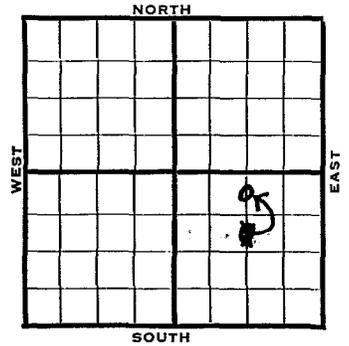

1940	REPORT
6/12	R.O.G.
6/20	8" - 316' Drig. 1281'
6/27	Lans. 3067' Arb. 3334'
	T.D. 3336' 4" - 3335' RUST.
7/3	T.D. 3340' 3000 acid.
	Pump 189 bbls. 12 hours.
7/10	Arb. 3334'
	4" - 3335'
	T.D. 3342'
	5500 acid.
	Echometer potential 934 bbls.
	COMPLETED

KANSAS

Russell

Form 51-5M-7-39-Palace

Section 32 Township 15 Range 13-W

Well No. ~~#14~~ Neidens #15

Company Skelly

Trapp Pool

