

Map No. 73 Sec. 32 Twp. 15 R. 13WWell No. 14 Neidens

Skelly Oil

Company

FIRST REPORT

Contractor

C E L S E

SECTION PLAT

1323 Ft. from N. Line

Ft. from S. Line

330 Ft. from E. Line

Ft. from W. Line

TRAPP POOL

Location

RECORD

Cased in., ft.

Sand

Gas

Oil

Total Depth

PRODUCTION

1st 24 hrs. Nat.

1st 24 hrs. after shot

Gas Cu. Ft.

Dry Hole

Abandoned

Date

MAY 15 1940

19

S. J. LEWIS

Scout

Map No. 73 Sec. 32 Twp. 15 R. 13WWell No. 14 Neidens

Skelly Oil

Company

Contractor

COMPLETED

SECTION PLAT

C E L S E

1323 Ft. from N. Line

Ft. from S. Line

330 Ft. from E. Line

Ft. from W. Line

TRAPP POOL

Location

RECORD

Cased in., ft.

Sand

Gas

Oil

Total Depth 3333

PRODUCTION

1st 24 hrs. Nat.

1st 24 hrs. after shot

Gas Cu. Ft.

Dry Hole

Abandoned

*At 3328.**5" 33329**1500 Acid**Echometer PT**13138**Map 3000*

Date

JUN 5 1940 19

S. J. LEWIS

Scout

KANSAS

Russell

Sec. 32 Twp. 15 R. 13-WWell No. #14 Neidens FarmSkelly Oil Company

(Trapp)


1323 Ft. from N. Line

Ft. from S. Line

330 Ft. from E. Line

Ft. from W. Line

Elev. 1890

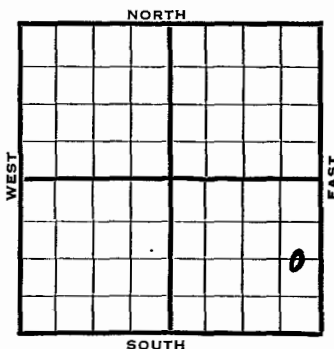

REPORT

1940
 5/15 Rotary.
 5/23 8" - 313' Drlg. 2852'
 5/29 Lans. 3070' Arb. 3330-32' T.D.
 5" - 3331' RUST.
 6/5 Arb. 3328'
 5" - 3329'
 T.D. 3333'
 1500 acid.
 Echometer potential 13,138 bbls.
 Maximum 3000 bbls.

COMPLETED

KANSAS

Form 51-5M-7-39-Palace

Russell

Section 32 Township 15 Range 13-WWell No. #14 NeidensCompany Skelly Oil