

Map No. 73 Sec. 32 Twp. 15 R. 13W

Well No. 13 Neidens

Skelly Company

Contractor

FIRST REPORT

C N L S 1/2 SE

SECTION PLAT

|  |  |  |  |
|--|--|--|--|
|  |  |  |  |
|  |  |  |  |
|  |  |  |  |
|  |  |  |  |

Ft. from N. Line

993 Ft. from S. Line

1320 Ft. from E. Line

Ft. from W. Line

TRAPP POOL

Location

RECORD

Cased in. ft.

Sand

Gas

Oil

Total Depth

PRODUCTION

1st 24 hrs. Nat.

1st 24 hrs. after shot

Gas Cu. Ft.

Dry Hole

Abandoned

Date

APR 24 1940 19

S. J. LEWIS Scout

Map No. 73 Sec. 32 Twp. 15 R. 13W

Well No. 13 Neidens

Skelly Company

Contractor

COMPLETED

C N L S 1/2 SE

SECTION PLAT

|  |  |  |  |
|--|--|--|--|
|  |  |  |  |
|  |  |  |  |
|  |  |  |  |
|  |  |  |  |

Ft. from N. Line

993 Ft. from S. Line

1320 Ft. from E. Line

Ft. from W. Line

TRAPP POOL

Location

RECORD

Cased in. ft.

Sand

Gas

Oil

Total Depth 3323

PRODUCTION

1st 24 hrs. Nat.

1st 24 hrs. after shot

Gas Cu. Ft.

Dry Hole

Abandoned

Date

MAY 15 1940 19

S. J. LEWIS Scout

Ca 43318.  
 5" @ 3319  
 1000 acid  
 Echometer 28  
 8822  
 Hoffmann 3000

Sec. 32 Twp. 15 R. 13-W

Well No. #13 Neidens Farm

Skelly Company

(Trapp)


Ft. from N. Line

993 Ft. from S. Line

1320 Ft. from E. Line

Ft. from W. Line

Elev. 1876

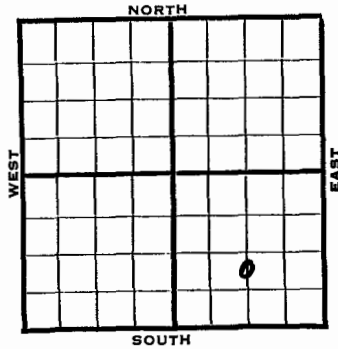

| 1940 | REPORT                          |
|------|---------------------------------|
| 4/24 | Rotary.                         |
| 5/2  | 8-5/8" - 319' Drlg. 2203'       |
| 5/9  | Lansing 3061' Arb. 3318-20'     |
|      | T.D. 3320' 5 1/2" - 3319' RUST. |
| 5/15 | Arb. 3318'                      |
|      | 5" - 3319'                      |
|      | T.D. 3323'                      |
|      | 1000 acid.                      |
|      | Echometer potential 3822 bbls.  |
|      | Maximum 3000 bbls.              |
|      | <b>COMPLETED</b>                |

Section 32 Township 15 Range 13-W

Well No. #13 Neidens

Company Skelly

NORTH Trapp Pool

