



Russell KANSAS

SEC.	TWP.	R.
32	15	13W

WELL NO. 1 Michaelis FARM

COMPANY Bennett & Roberts

CONTRACTOR Co. Tools  
Trapp Pool


\_\_\_\_\_ Ft. from N. Line

330 \_\_\_\_\_ Ft. from S. Line

\_\_\_\_\_ Ft. from E. Line

1320 \_\_\_\_\_ Ft. from W. Line

C S/2 S/2 SW

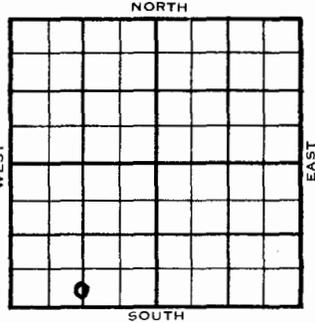

	ELEVATION	REPORT
1955	1876'	

3/16 Spud 3-11-55  
8" @ 846'  
Anhy 841'  
Drlg. 1591'

6/1 Comm 3-11-55  
Anh 841, H 2996, Tr 3014, B1 3067  
L 3078, A 3315, TD 3316  
8" @ 846 DST 3157-63 open 2 hr.  
Rec 28' hocm 320/30" DST 3233-45  
open 1 hr Rec 9' vocm 9' mud  
500/30" DST 3301-10 DST 3399-3408  
open 1 hr Rec 7' mud TD 3316 5" @ 3316  
S/40 bopd 360 bw  
Comp 25 bopd

**COMPLETED**

DX 78-1

Russell KANSAS

Section 32 Township 15 Range 13 W

Well No. # 1 Michaelis

Company Bennett & Roberts

