



Russell KANSAS

Sec. 32 Twp. 15 R. 13W

Well No. #13 Michaelis Farm

Gulf Oil Company

Barbour Contractor

Trapp Pool


Ft. from N. Line

990' Ft. from S. Line

990' Ft. from E. Line

Ft. from W. Line

NW SE SW

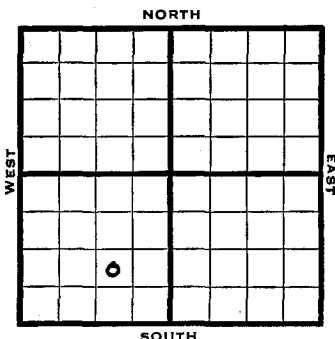

1950 Elev 1867 REPORT

8/23 Spud 8-19-50  
Anhy 829'  
Running 8"

10/4 Anhy 829 Lans 3049

Arb 3303-15  
7" @ 3303  
TD 3315  
FU 200' oil 20 min  
S/60 bo 100 bw 4 hr PB 3306  
S/13 bf est 50% water 12 hr 500 A  
S/56 bo 120 bw 4 hr  
Comp 155 bo 565 bwpd  
Completed

COMPLETED

Russell KANSAS

Section 32 Township 15 Range 13W

Well No. #13 Michaelis

Company Gulf Oil

