

Russell KANSAS

Map No. 73 Sec. 32 Twp. 15 R. 13 W

Well No. 7-Michaelis

Gulf Company Contractor

FIRST REPORT

SECTION PLAT

990 Ft. from N. Line
Ft. from S. Line
425 Ft. from E. Line
Ft. from W. Line

Grid with '0' in the center

Location

RECORD

Cased in. ft.
Sand
Gas
Oil
Total Depth

PRODUCTION

1st 24 hrs. Nat.
1st 24 hrs. after shot
Gas Cu. Ft.
Dry Hole
Abandoned

Rig up

Drilling and Remarks:

BRR

Date

MAY 19 1937

H. D. Hatfield Scout

Russell KANSAS

Map No. Sec. 32 Twp. 15 R. 13 W

Well No. 7-Michaelis

Gulf Company Contractor

COMPLETED

SECTION PLAT

990 Ft. from N. Line
Ft. from S. Line
425 Ft. from E. Line
Ft. from W. Line

Grid with '0' in the center

Location

RECORD

Cased 6 in. 3284 ft.
Sand 511 3284
Gas
Oil
Total Depth 3297

PRODUCTION

1st 24 hrs. Nat.
1st 24 hrs. after shot
Gas Cu. Ft.
Dry Hole
Abandoned

Rig up

Drilling and Remarks:

4000 Acid

Pump 928/12

Pot 1856

Date

JUN 30 1937

H. D. Hatfield Scout

Sec. 32 Twp. 15 R. 13-W

Well No. #7 Michaelis Farm

Gulf Company


990 Ft. from N. Line

\_\_\_\_\_ Ft. from S. Line

425 Ft. from E. Line

\_\_\_\_\_ Ft. from W. Line


Elev. 1847

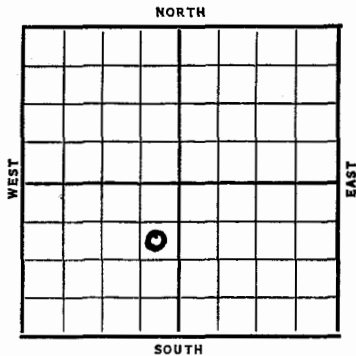

Section 32 Township 15 Range 13-W

Well Number 7 - Michaelis

Company Gulf

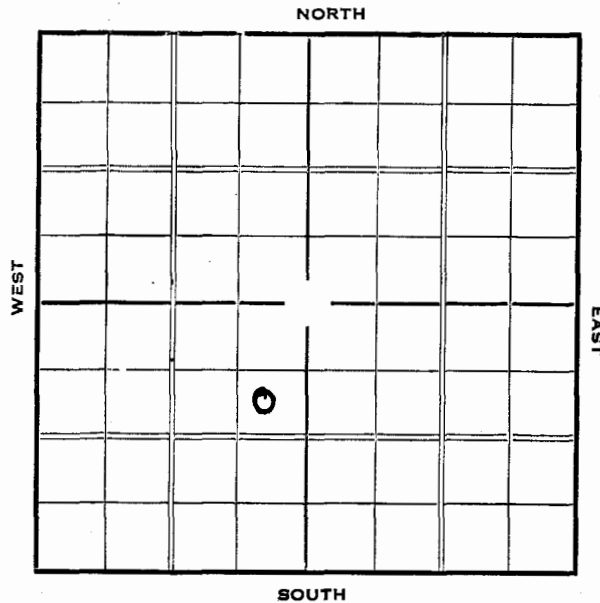

Date	REPORT
1937	
5/19	B. R. R.
5/28	" "
6/4	Drlg. 400'.
6/11	Drlg. 2190'.
6/19	10" @ 606'. Drlg. 3197'.
6/25	Sil. 3284'. 6" @ 3284'.
	T.D. 3297'. 4000 acid.
6/30	6" @ 3284'.
	Sil. 3284'.
	T.D. 3297'.
	4000 acid.
	Pump 928 bbls. 12 hrs.
	Potential 1856 bbls.
	<b>COMPLETED</b>